

T.25S, R.12.W, W. M.

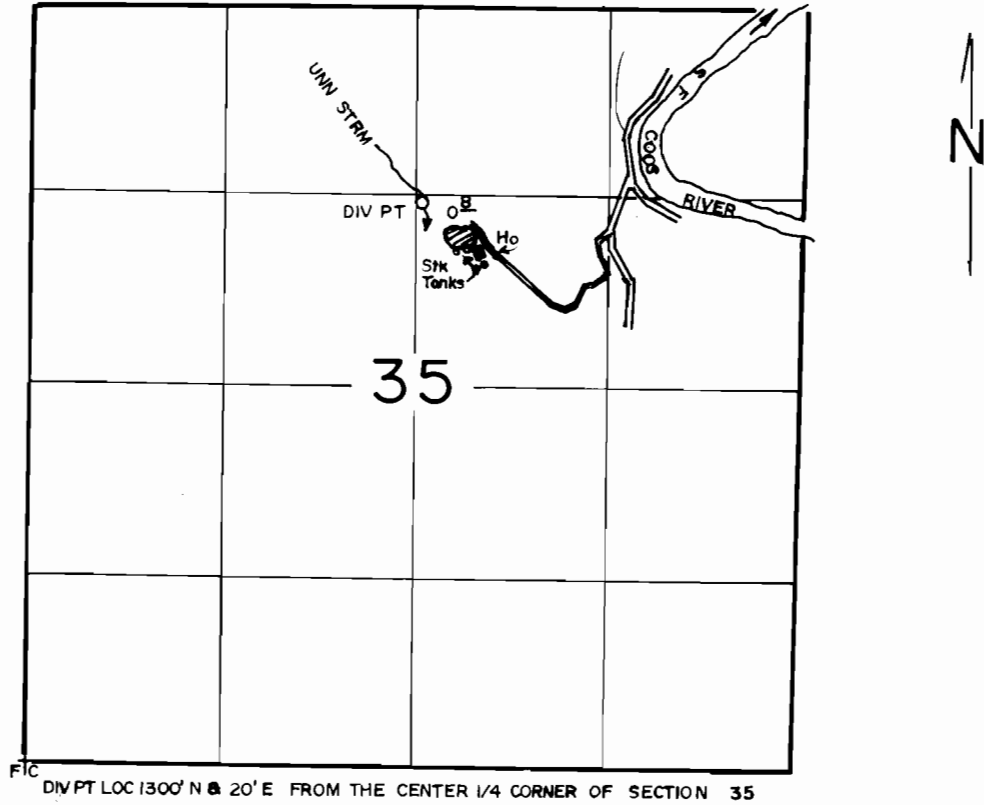


FIG DIV PT LOC 1300' N & 20' E FROM THE CENTER 1/4 CORNER OF SECTION 35

SCALE: 1" = 1320'

FINAL PROOF SURVEY
UNDER

Application No. 57743..... Permit No. 43499.....
IN NAME OF

.....**TONI E. OR JOSEPH L. BLISSECK**.....

Surveyed JULY 11..... 1989., by J.M. SHORDE.....