


T. 4 N., R. 2 W., W.M.

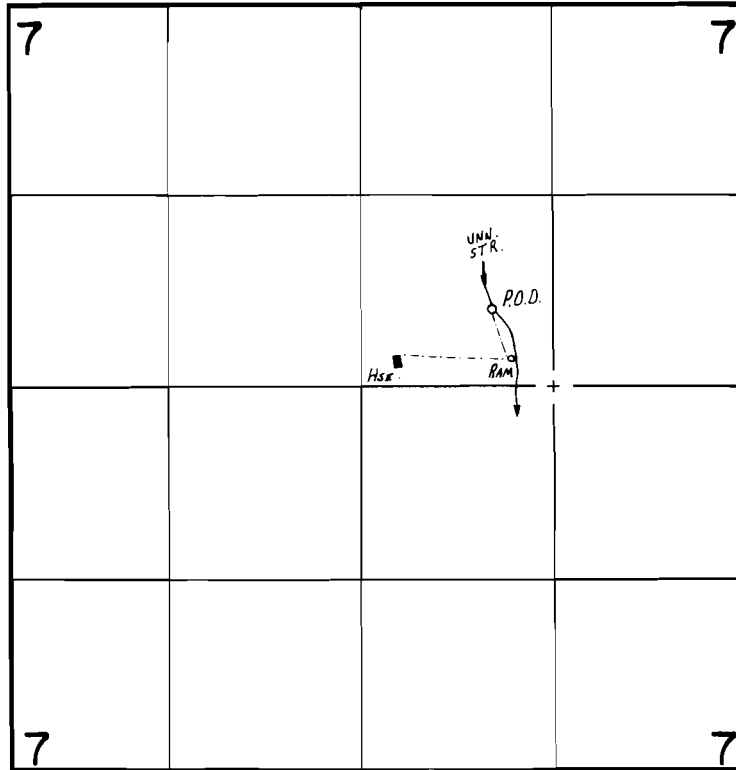

P.O.D. Loc. : 540' N. & 410' W. from SE Cor. SW⁴ NE⁴ Sec. 7.

Scale: 1" = 1320'

FINAL PROOF SURVEY UNDER

Application No. 61161..... Permit No. 46759.....

IN NAME OF

WILLIAM A. VAN LEER

Surveyed JUNE 5, 1986., by T. Warren.....