


# T. 38 S., R. 1 W., W. M.

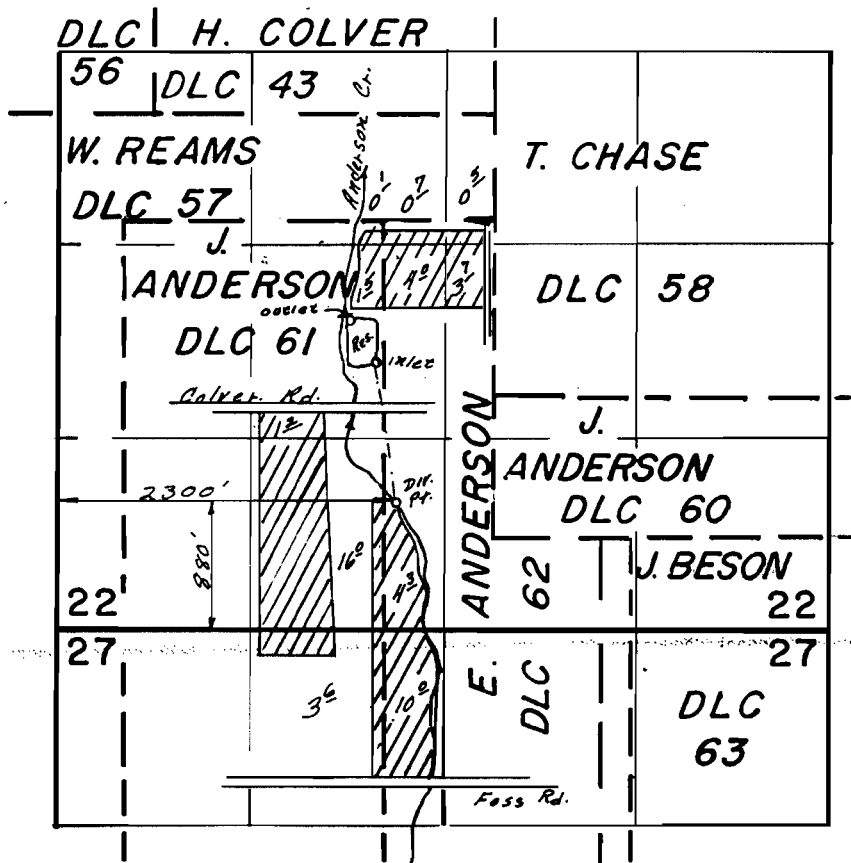

SCALE: 1" = 1320'

## FINAL PROOF SURVEY

UNDER

R-61197                  R-8350

Application No. 61198... Permit No. 46444

IN NAME OF

HIGHCROFT ORCHARDS

Surveyed MAR. 6, 1986, by B. S. JAMES