90984

T. 3S., R. 39E., W.M.

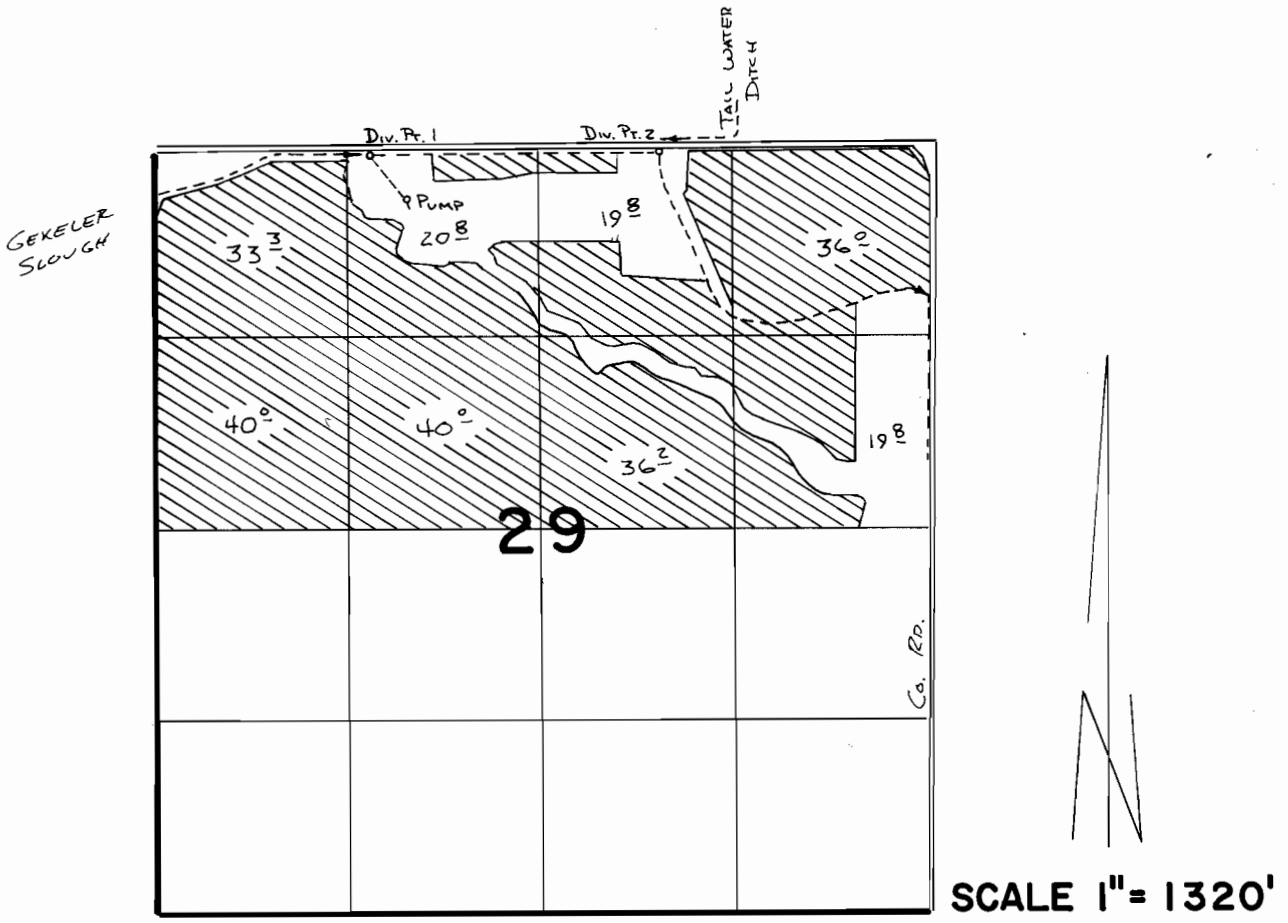

Div. Pt. 1 Loc: 50'S. & 1150'W.
Div. Pt. 2 Loc: 30'S. & 830'E.
} From N1/4 Cor. Sec 29

FINAL PROOF SURVEY
UNDER

Application No. 61333. Permit No. 46797
IN NAME OF

BYRON W. & JEAN HAWKINS

Surveyed June 23 1987, by V.L. Church

4106 1 179-27 8L VLC