


T. 1S., R. 38E., W. M.

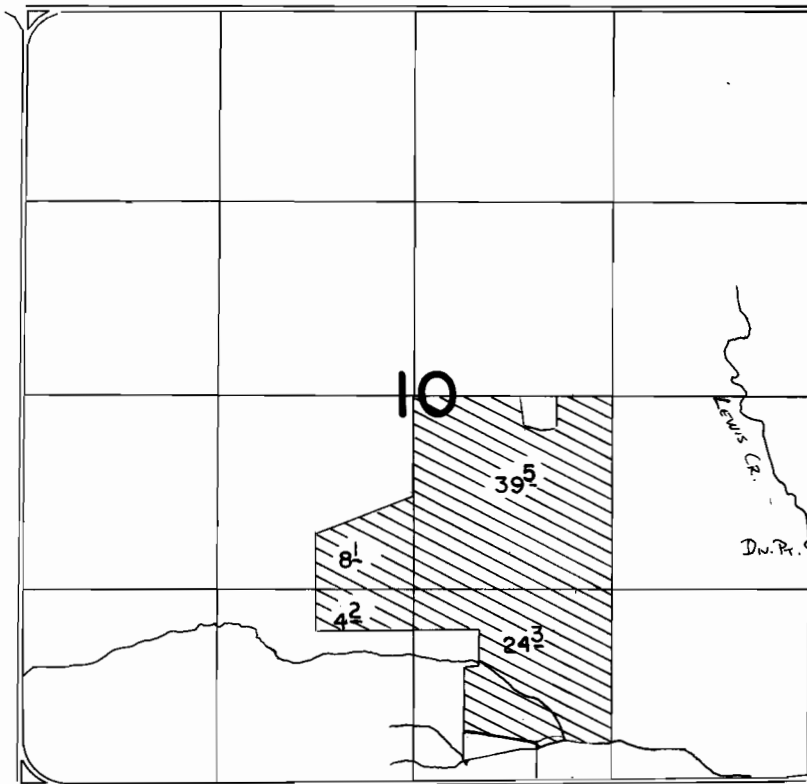

SCALE 1"=1320'



Div. Pt. Loc: 1010'S. & 10' W. FROM E 1/4 CORNER SECTION 10

FINAL PROOF SURVEY UNDER

Application No. **61343** Permit No. **46374**
IN NAME OF

ALFRED A. ARNOLDUS

Surveyed 4-2-1987, by V. h. Church