


T.5S., R.1E., W.M.

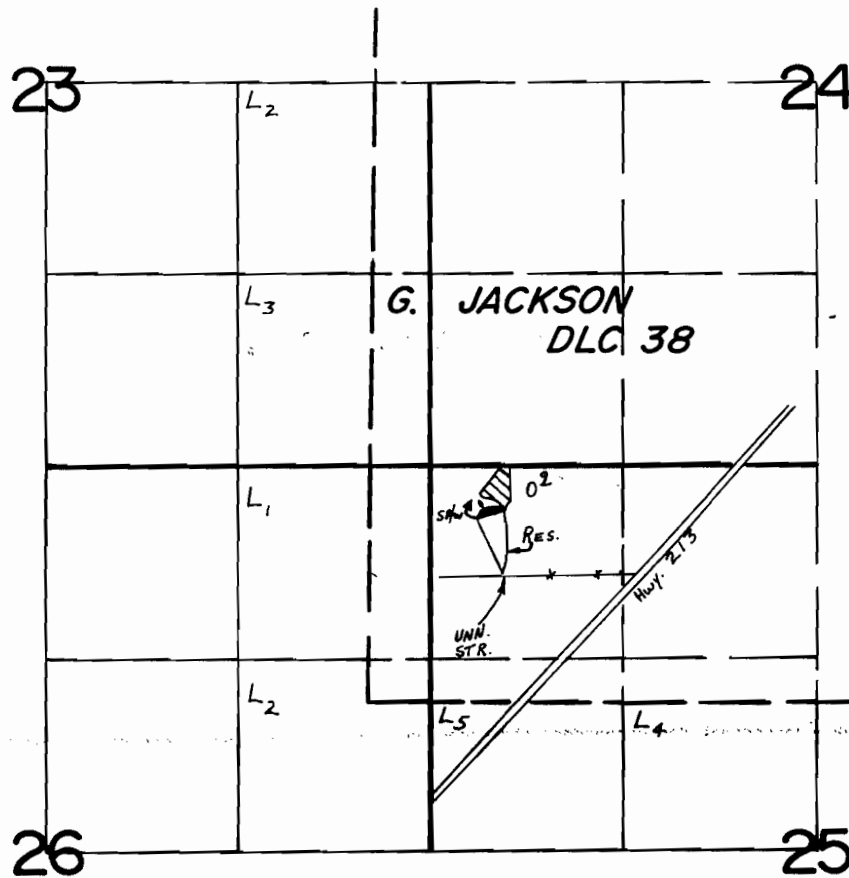

P.O.D. Loc. : 350' S. & 400' E. from NW Cor. Sec. 25.

Scale : 1" = 1320'

FINAL PROOF SURVEY
UNDER

R-61884
R-64534

R-8352
R-8547

Application No. 64535.. Permit No. 47235.....
IN NAME OF

CARL F. & BARBARA M. JACKSON

Surveyed JUNE..26 1986., by ...T.Warren.....

PTS- 1986-A
DFK-3P-96
1/22/87 TMW