


T.17 S., R.27 E., W.M.

P-46736
C-64359

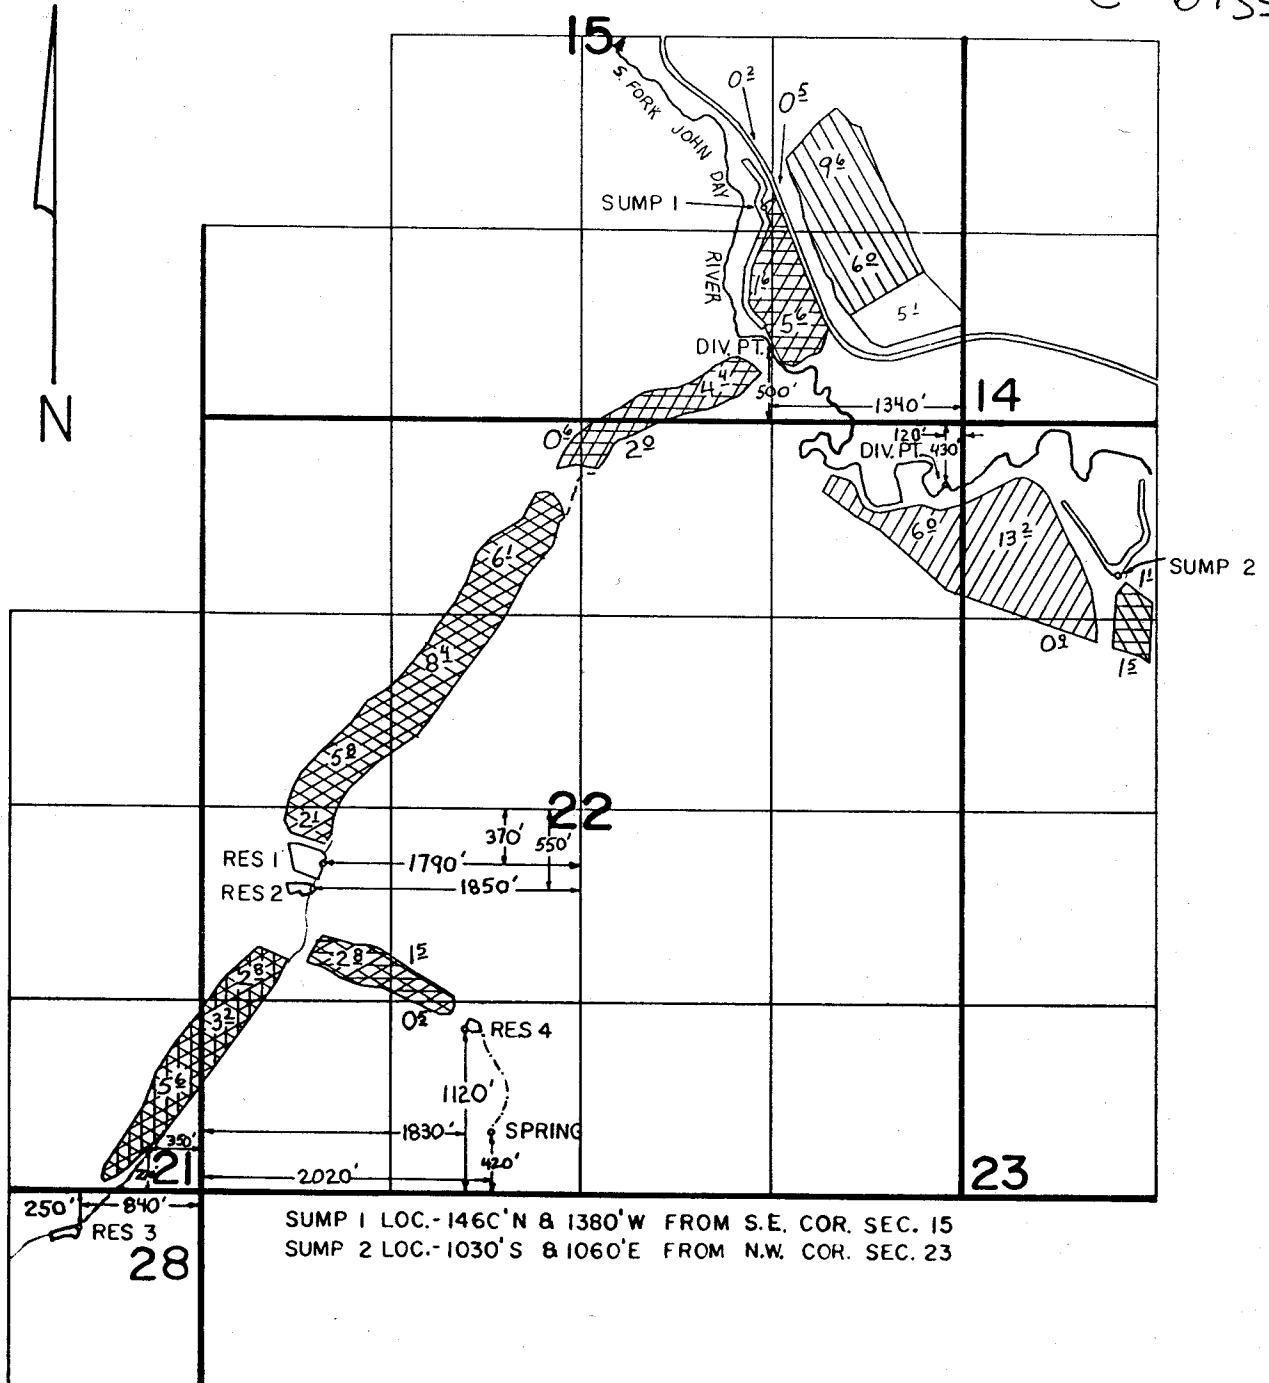

SUMP 1 LOC.- 146C' N & 1380' W FROM S.E. COR. SEC. 15
SUMP 2 LOC.- 1030' S & 1060' E FROM N.W. COR. SEC. 23

FINAL PROOF SURVEY

UNDER

G10505

62168

62170

G9744

46736

46681

Application No. R62169 Permit No. R.8402.....

IN NAME OF

W.R. ROGERS

Surveyed April 23, 1986, by J.M. Toll.....

G9744	SUMP 1	SUMP 2
46736	DIV. PT. 1	DIV. PT. 2
46681	RES 1 & 2	RES 3
	RES 4	