


T.17 S., R.27 E., W.M.

P-46736
C-64359

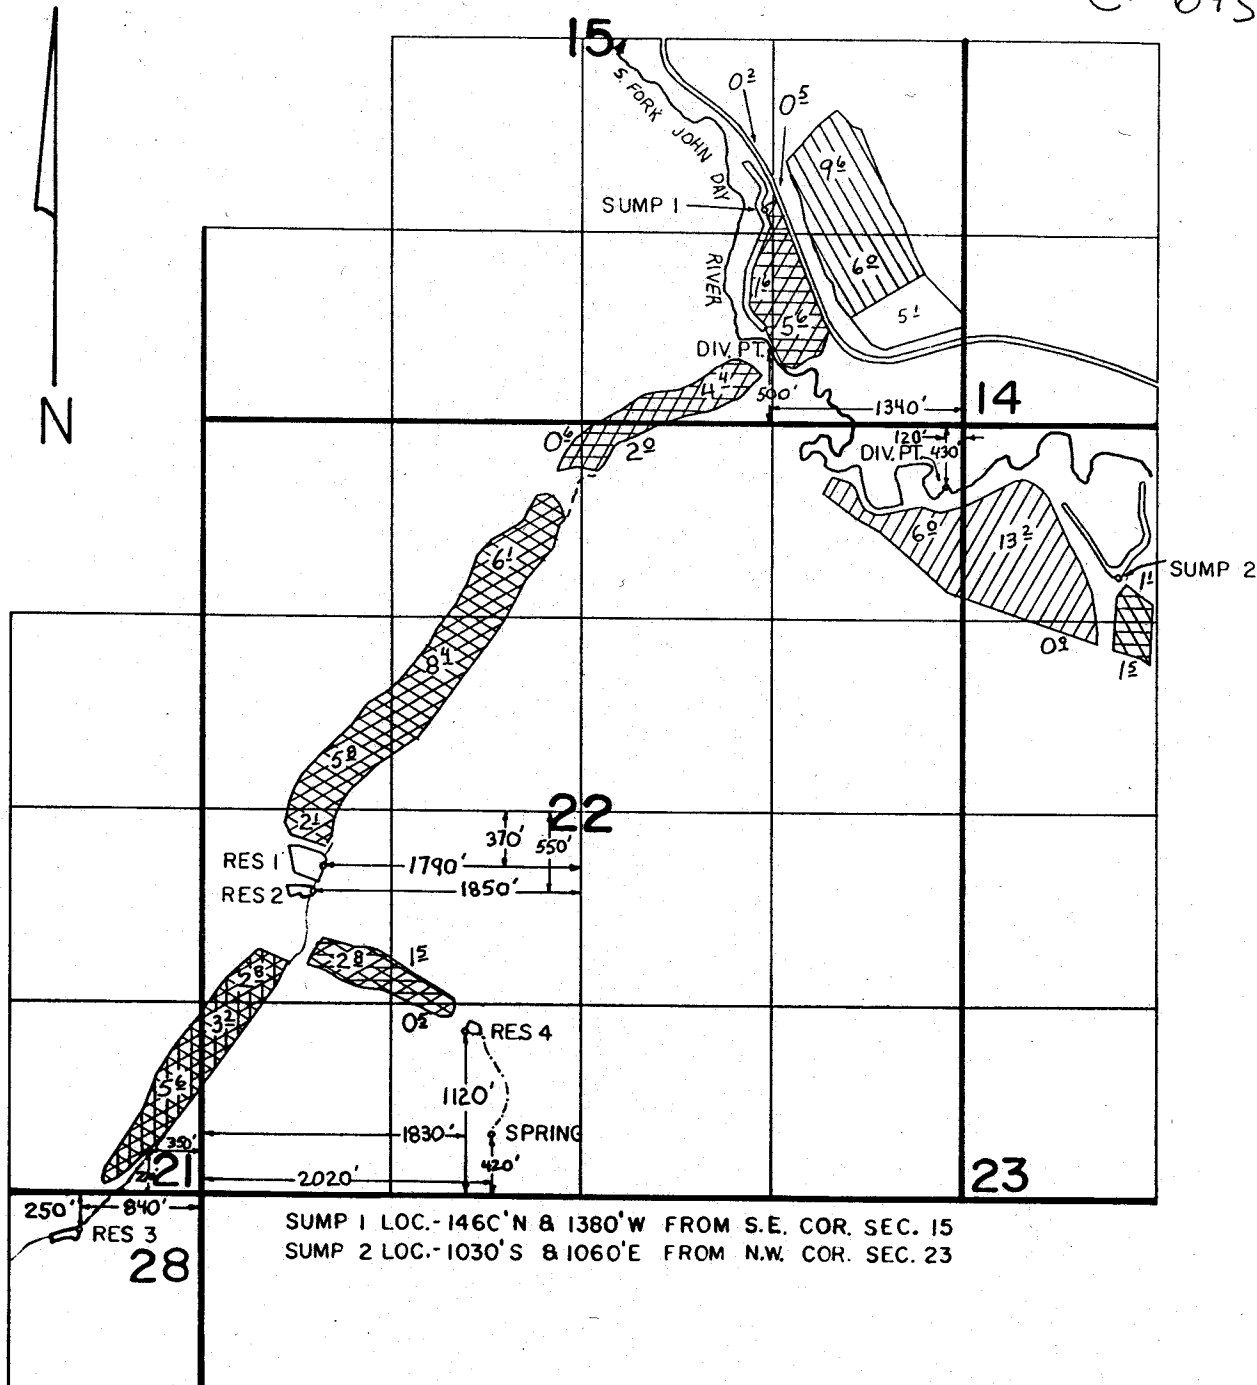

SUMP 1 LOC. - 146C' N & 1380' W FROM S.E. COR. SEC. 15
SUMP 2 LOC. - 1030' S & 1060' E FROM N.W. COR. SEC. 23

FINAL PROOF SURVEY

UNDER

G10505

62168

62170

G9744

46736

46681

Application No. R.62169... Permit No. R.8402.....

IN NAME OF


W.R. ROGERS

Surveyed April 23, 1986, by J.M. Toll.....

G9744

SUMP 1

SUMP 2

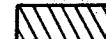

46736

DIV. PT. 1

DIV. PT. 2



46681

RES 1 & 2

RES 3



RES 4

