


T. 1 S., R. 3 W., W. M.

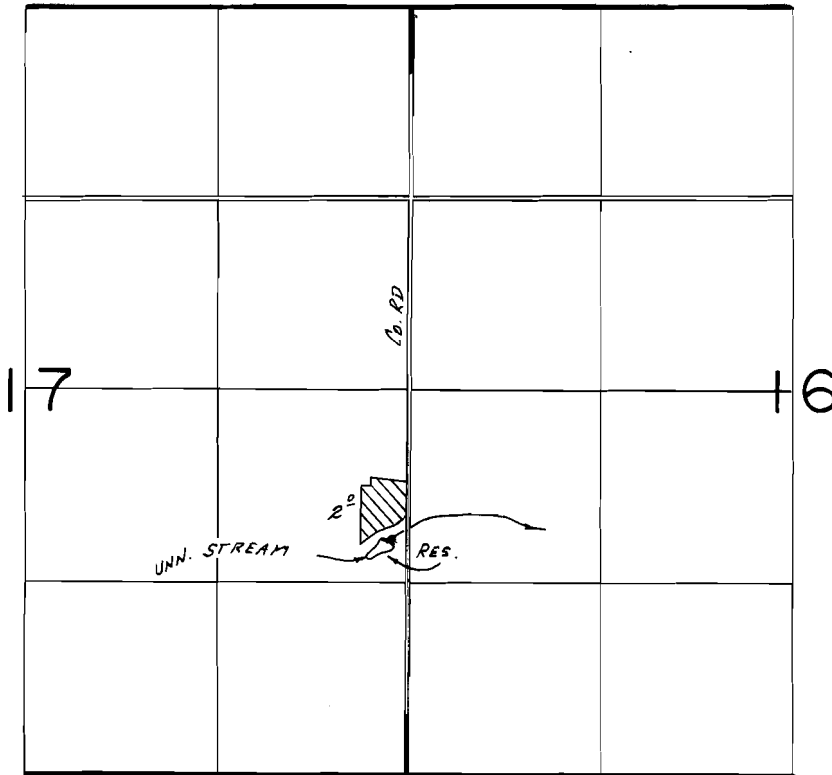

Div. Pt. Loc.: 160' N. & 130' W. FROM SE COR. SEC. 17

SCALE: 1" = 1320'

FINAL PROOF SURVEY UNDER

R-62341 R-8407
Application No. 62342. Permit No. 46701.....
IN NAME OF

.....PHYLLIS K. BASS.....

Surveyed Aug. 29, 1986, by B.W. BISHOP.....

1-27-87
BWB

41067-178-107 R