


T. 32S., R. 5W., W.M. SECTIONS 19 & 30

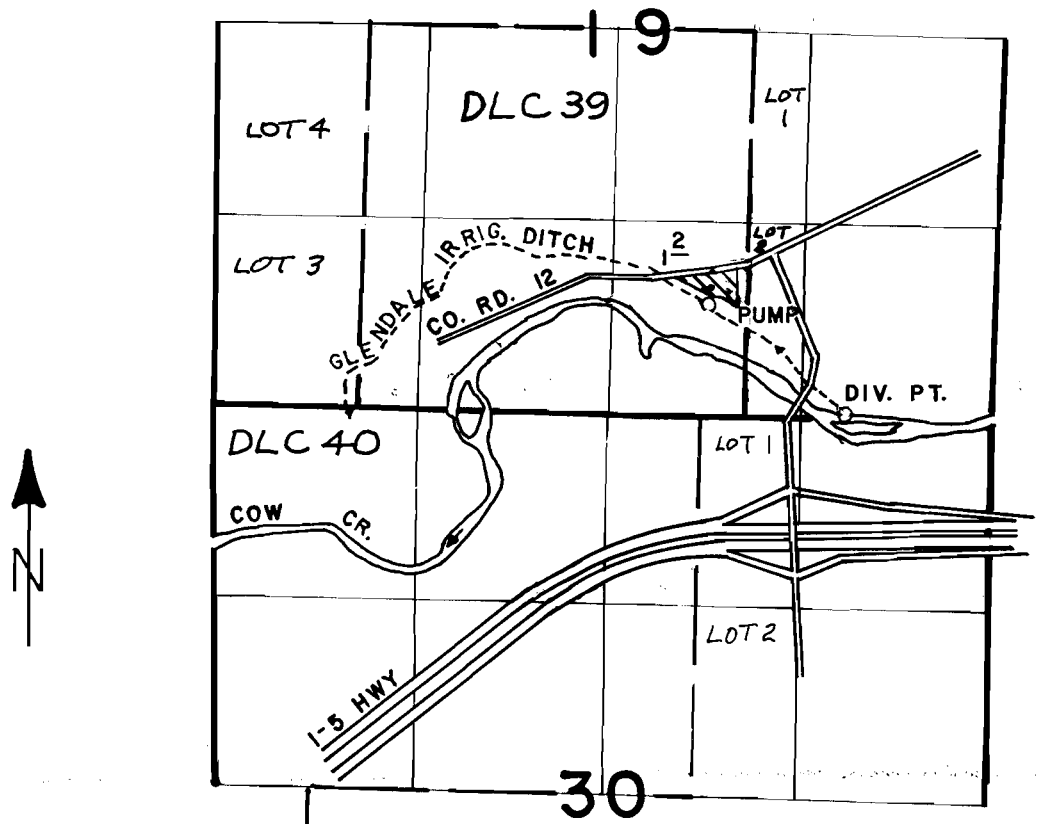

DIV. PT. LOCATED 40' N. & 1540' E. FROM S. 1/4 COR. SEC. 19.

SCALE: 4" = 1 MILE

FINAL PROOF SURVEY UNDER

Application No. 62345 Permit No. 46493....

IN NAME OF

RALPH E. CORDER.....

Surveyed AUG. 22, 1984, by L. E. CASHION....