


C-64322 P-46889
C-64365 P-46890

T12S, R26E, WM

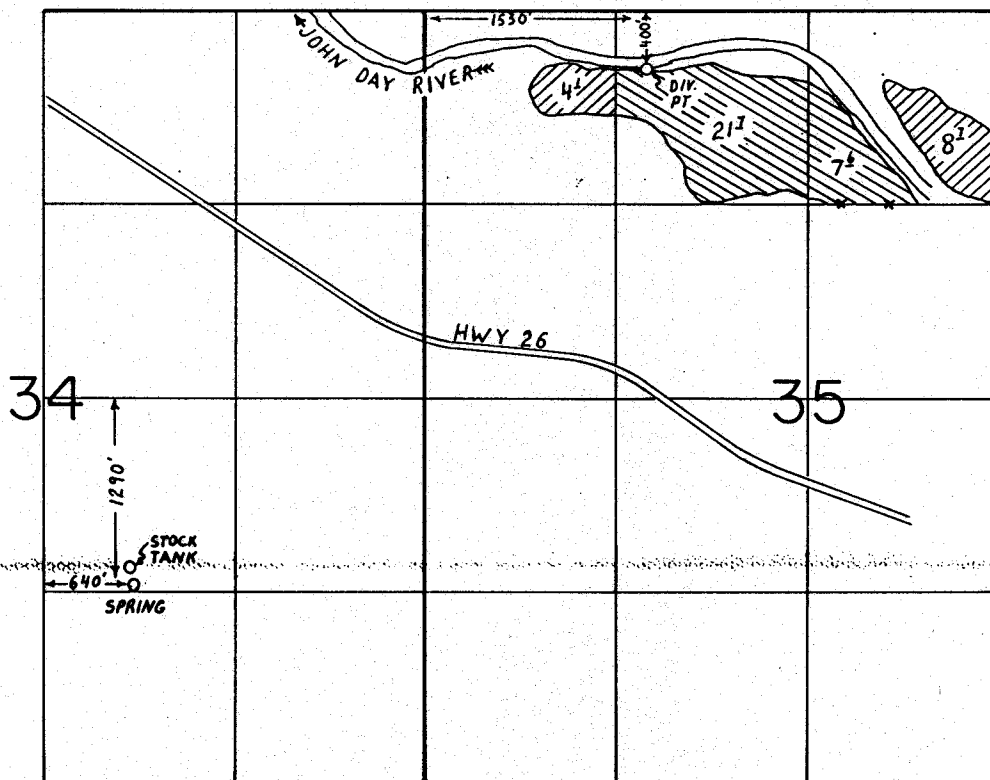

SCALE
1"=1320'

FINAL PROOF SURVEY UNDER

 PRIMARY IRR.

 SUPPLEMENTAL IRR.

62375 46889
Application No. 62376 Permit No. 46890....
IN NAME OF

COTTONWOOD LAND & CATTLE CO., INC.

Surveyed JUNE 18, 1988, by T.M. WARREN.

R/VK
PTS W/FF
41023 179 218