


T. 30 S., R. 5 & 6 W., W.M.

SECTIONS 25 & 30

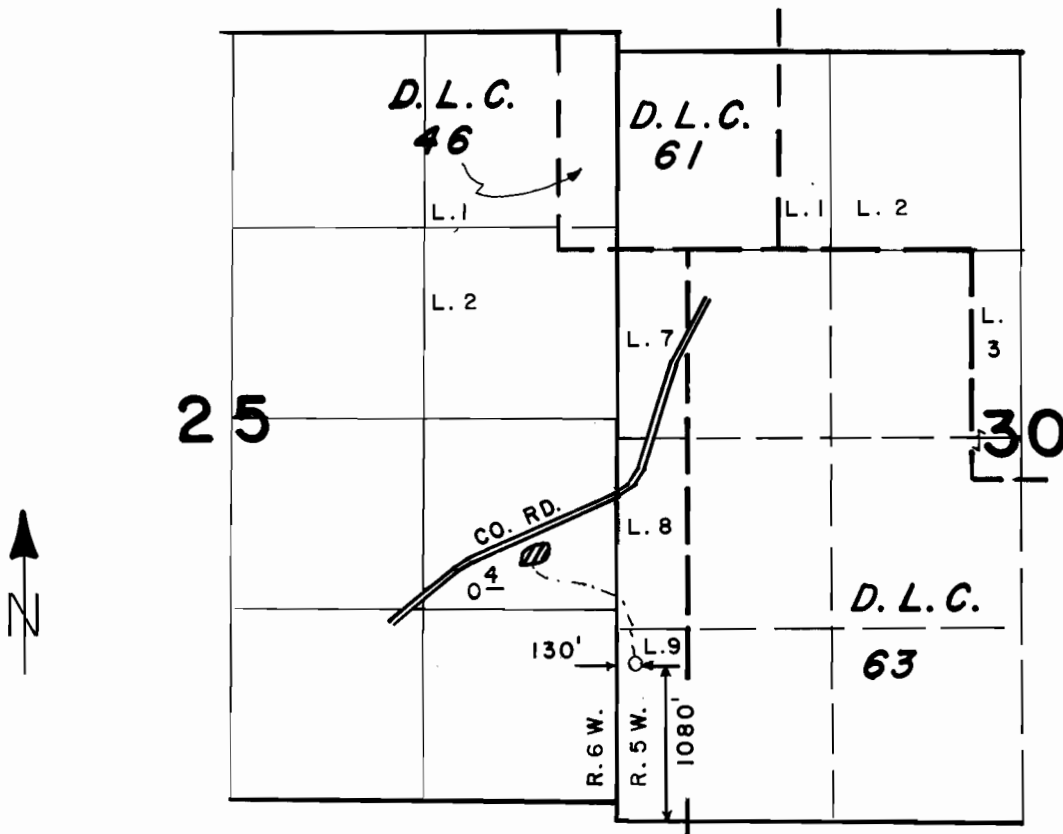

SCALE: 4" = 1 MILE

FINAL PROOF SURVEY UNDER

Application No. 62416. Permit No. 46685.....
IN NAME OF

MICHAEL J. & BONNE F H. SWETT

Surveyed JULY 8, 1987, by J. M. SCHMORDE