


# T. 36 S., R. 6 W., W. M.

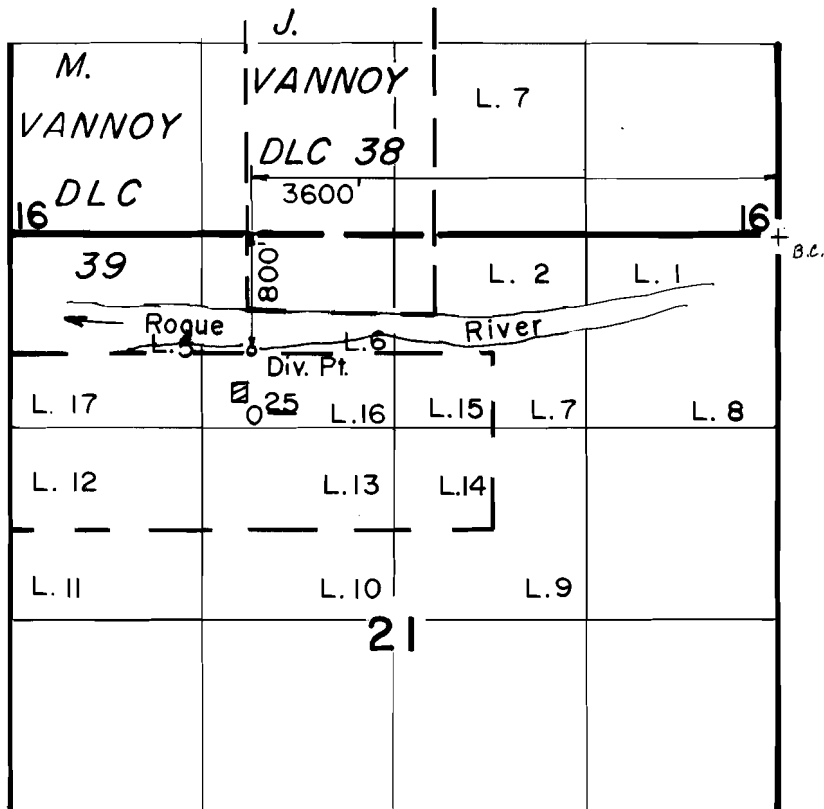

Scale: 1" = 1320'

## FINAL PROOF SURVEY UNDER

TRANSFER NO. 5138

Application No. 62985 Permit No. 47444.  
IN NAME OF

.....SOLVEIG W. LOZIER.....

Surveyed Sep. 21, 1987, by B. S. JAMES.....