


# T. 38 S., R. 1 W., W. M.

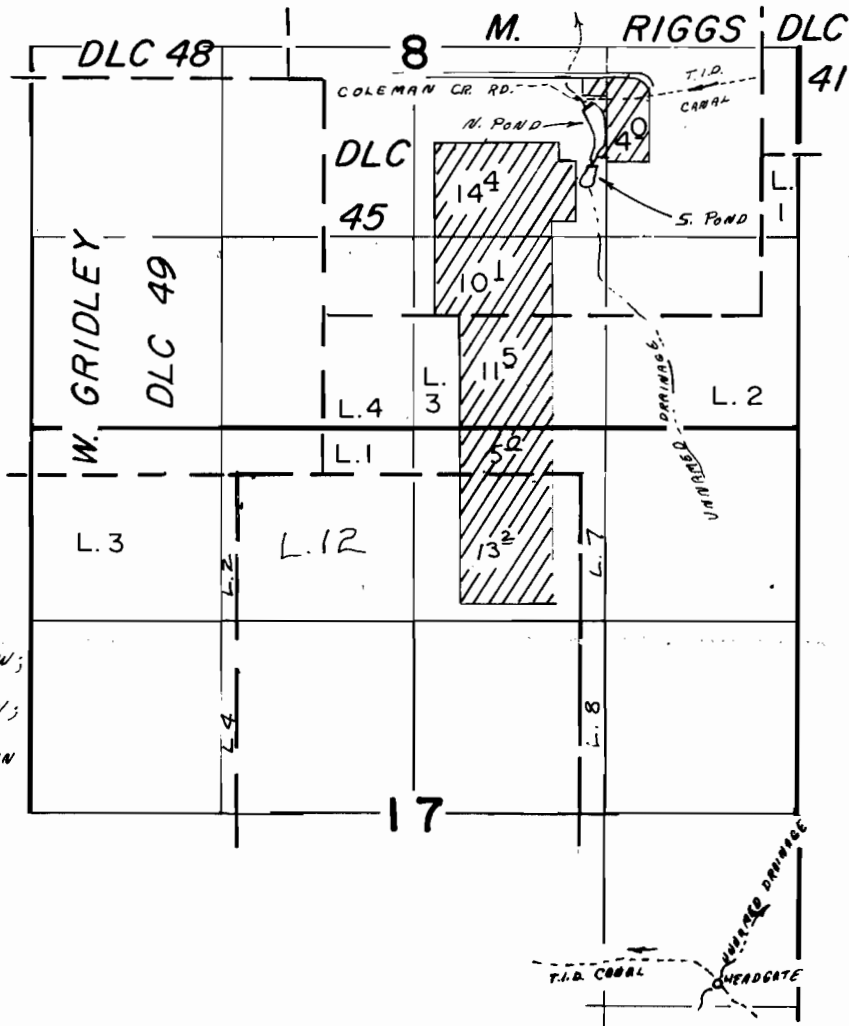

**LOCATIONS:**

NORTH POND: 2200' N., 1450' W;  
 SOUTH POND: 1790' N., 1430' W;  
 BOTH FROM SE COR SEC. 8, IN  
 NW 1/4 SE 1/4 SEC. 8, T. 38 S.,  
 R. 1 W., W. M.

## FINAL PROOF SURVEY

UNDER

R-63267

R-8437

Application No. 63268 Permit No. 46742

IN NAME OF

CRYSTAL SPRINGS PACKING CO.

Surveyed NOV. 19 1987, by B. S. JAMES