


T. 38 S., R. 1 W., W. M.

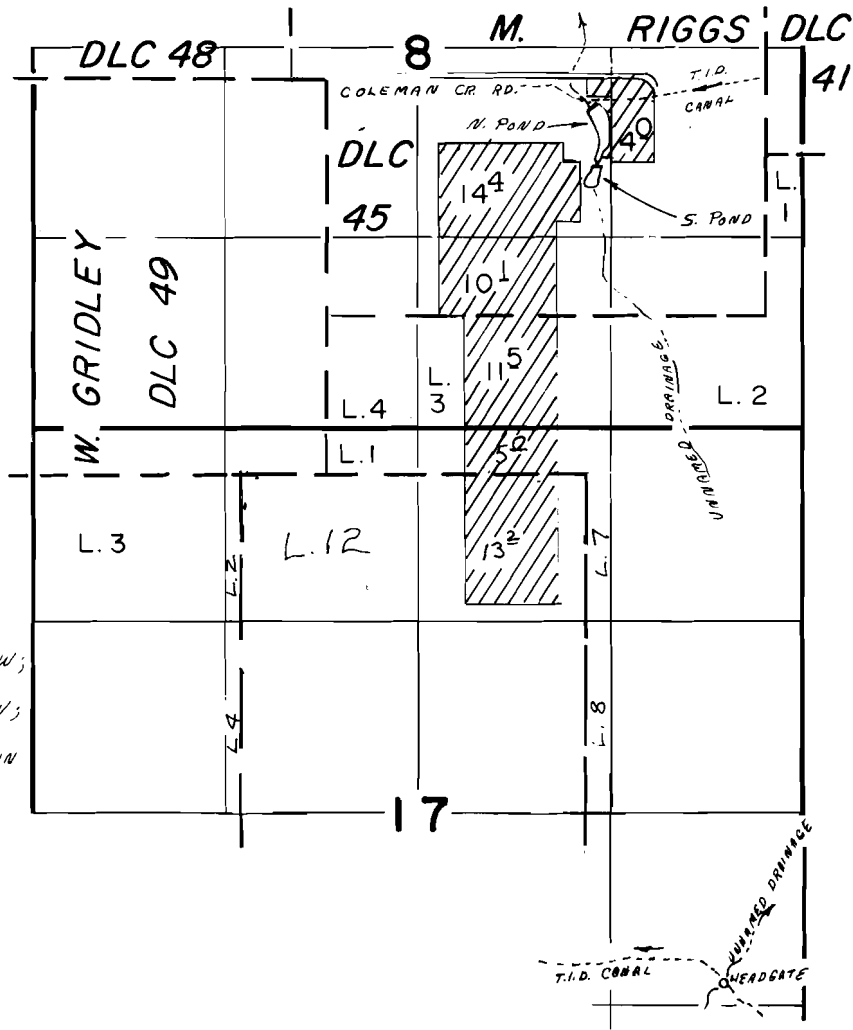

LOCATIONS:

NORTH POND: 2200' N., 1430' W;
 SOUTH POND: 1790' N., 1430' W;
 BOTH FROM SE COR SEC. 8, IN
 NW 1/4 SE 1/4 SEC. 8, T. 38 S.,
 R. 1 W., W. M.

FINAL PROOF SURVEY

UNDER

R-63267

R-8437

Application No. 63268 Permit No. 46742

IN NAME OF

CRYSTAL SPRINGS PACKING CO.

Surveyed NOV. 19. 19.87, by B. S. JAMES.