


# T. 1 S., R. 3 W., W. M.

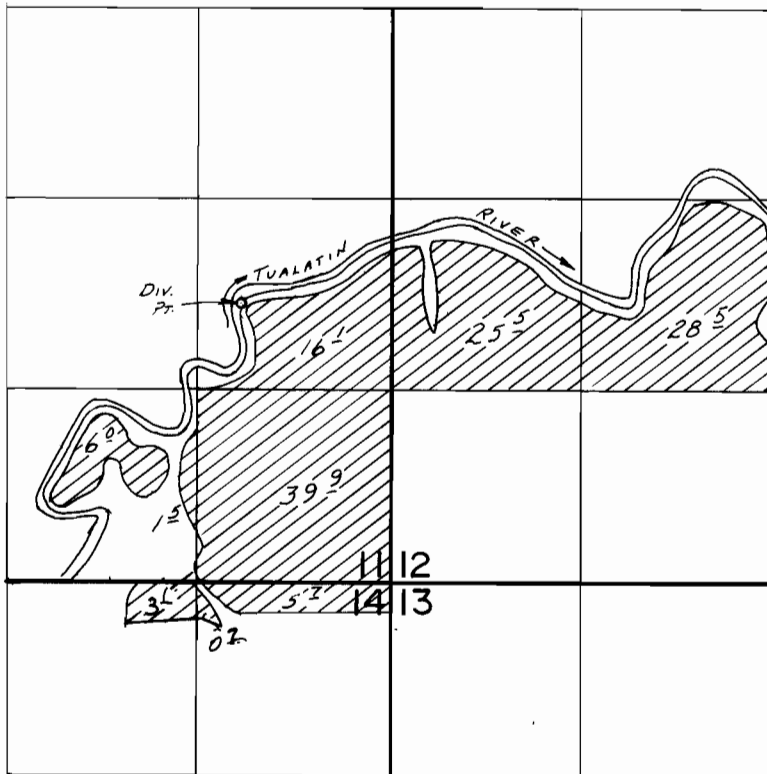

*Div. Pt. Loc.: 1920' N. & 1040' W. FROM SE COR. SEC. 11.*

SCALE: 1"=1320'

## FINAL PROOF SURVEY UNDER

Application No. 6338.7. Permit No. 4695.0....  
IN NAME OF

DANIEL F. HERING

Surveyed Aug. 12... 1986, by B.W. BISHOP.....

1/7/87  
RWB

41067-178-1408