


T. 35 S., R. 2 W., W. M.

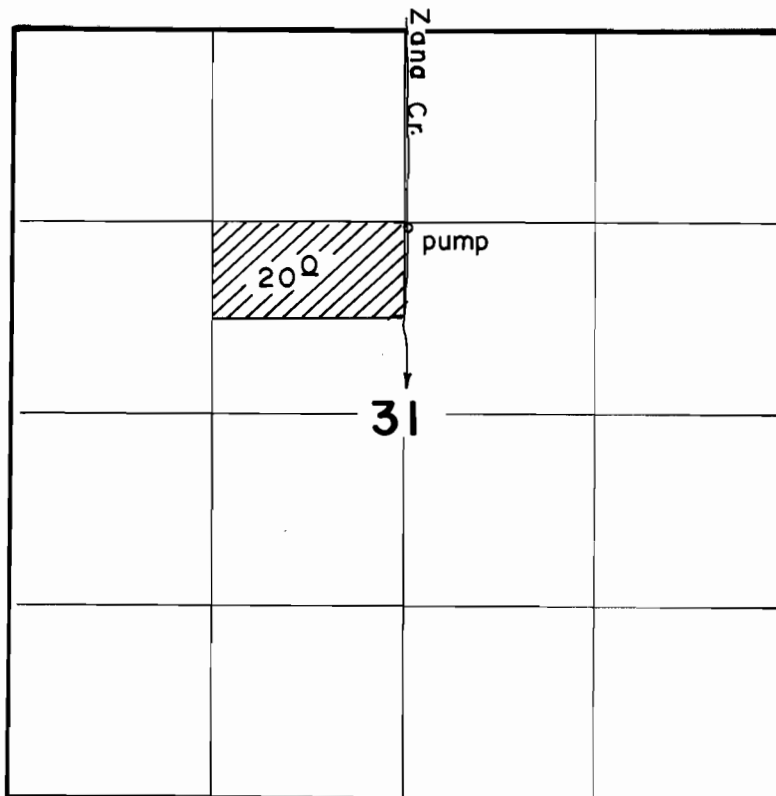

Scale: 1" = 1320'

Sams Valley Res. Div.: 2880' N., 1290' E., from SW cor. Sec. 18;
in SW 1/4 NW 1/4 Sec. 18, T. 35S., R. 2 W., W. M.

FINAL PROOF SURVEY UNDER

Application No. 63412. Permit No. 47252...
IN NAME OF

DALE P. SCHULTZ

Surveyed MAY 18, 1987, by B. S. JAMES.