


# T. 28S., R. 6W., W.M.

## SECTIONS 22 & 27

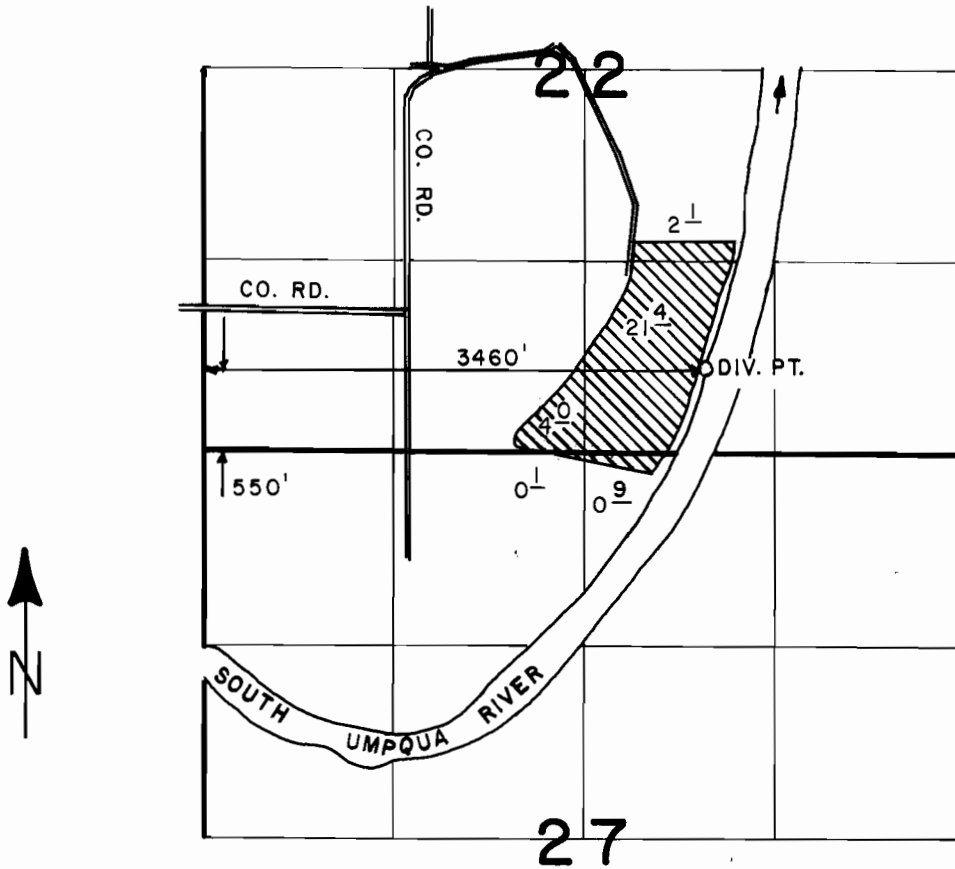

SCALE: 4 = 1 MILE

### FINAL PROOF SURVEY UNDER

Application No. 63429 Permit No. 46775  
IN NAME OF

.....DAVID K. BURKS.....

Surveyed MAY 6, 1987, by J. M. SCHMORDE