


T.3 S., R.1 W., W.M.

Sec. 17

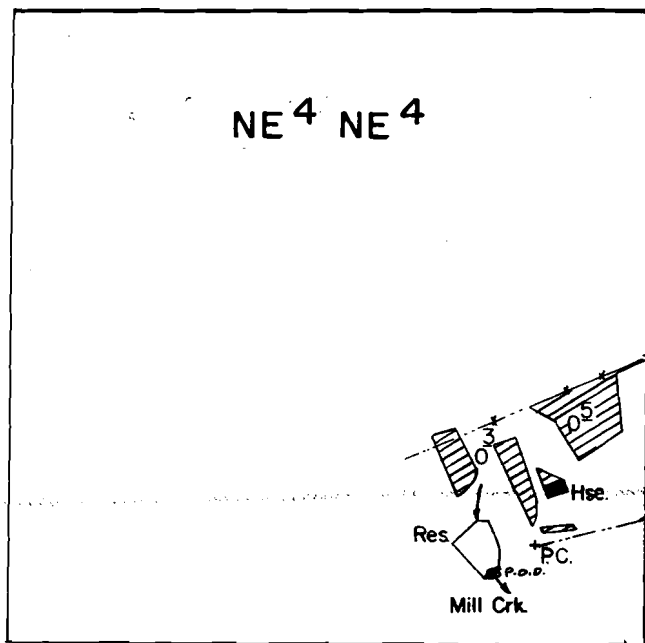

P.O.D. Loc.: 1180' S. & 320' W. from NE Cor. Sec. 17.

Scale : 1" = 400'

FINAL PROOF SURVEY
UNDER

R-63592

R-8503

Application No. 63818.. Permit No. 47048...

IN NAME OF

JOHNATHAN M. MARSHALL.....

Surveyed JULY 31, 1986., by T. Warren.....

PTS-1986-C

T.M.W. 2/6/87