


T. 9 S., R. 10 W., W.M

Sec. 34

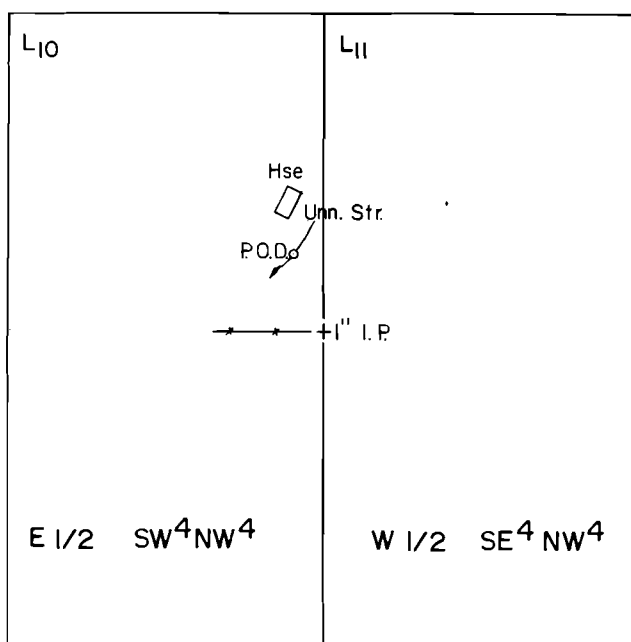

P.O.D. Loc. : 500' S. & 60' W. from NE Cor. SW⁴ NW⁴

Scale : 1" = 400'

FINAL PROOF SURVEY
UNDER

Application No. 63616 Permit No. 46785

IN NAME OF

MICHAEL LOYAL WILSON

Surveyed AUG. 6 1986, by T. Warren