


T.4S., R.3E., W.M.

Sec. 2

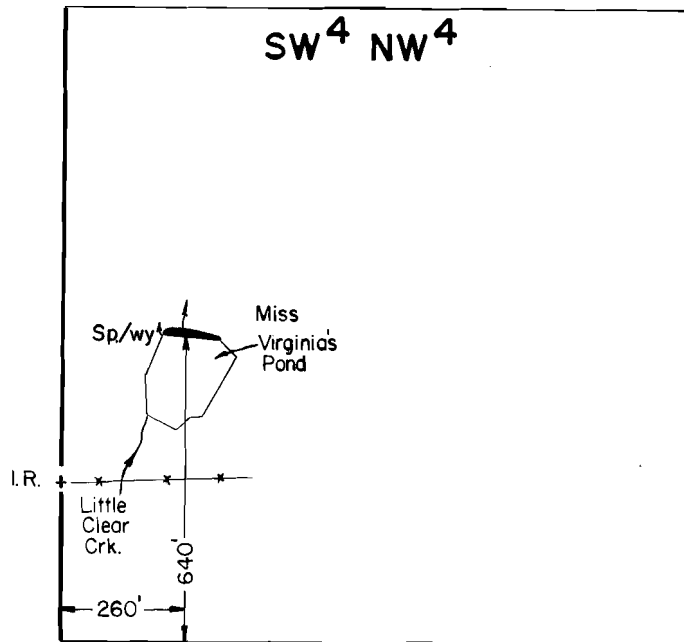

Scale: 1" = 400'

FINAL PROOF SURVEY UNDER

R-63644

R-8531

Application No. 63618. Permit No. 47154.....

IN NAME OF

VIRGINIA H. STALDER

Surveyed JULY 8 1986, by T. Warren.....

PTS-1986-A
TMW 1/29/87