


Application No. R-63644
Permit No. R 8531

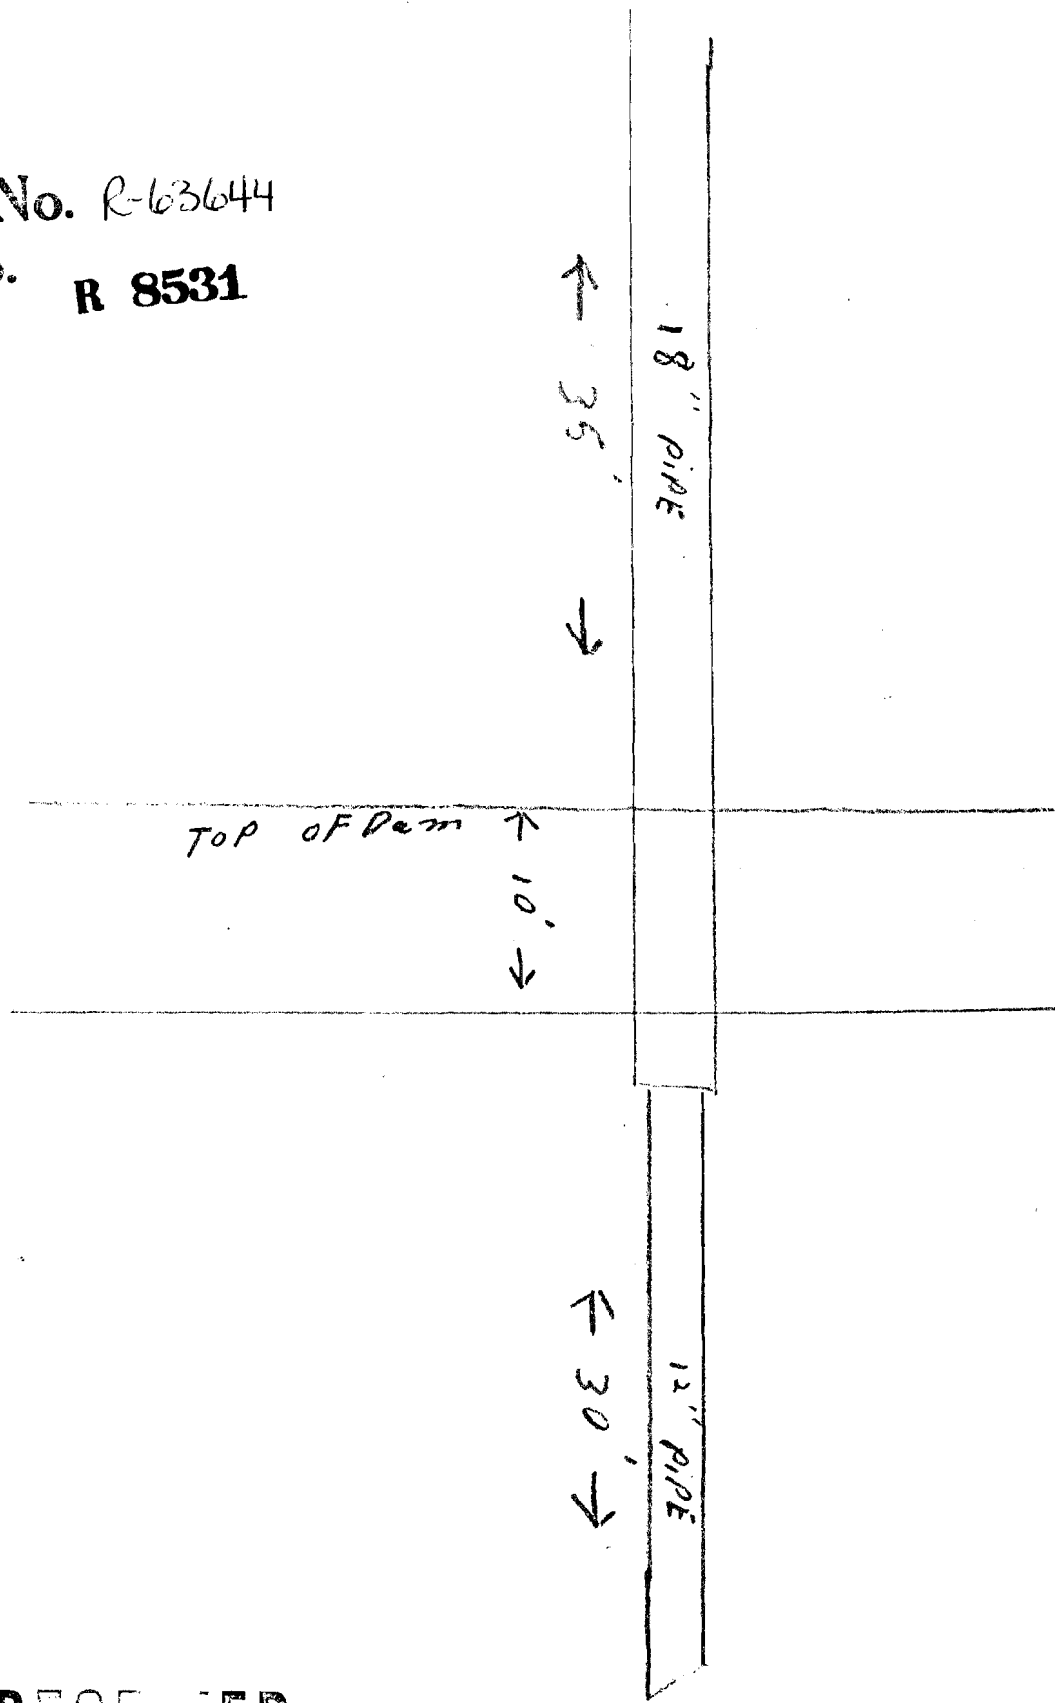

RECEIVED

JUN 14 1982

WATER RESOURCES DEPT
SALEM, OREGON