


T.30S., R.2W., W.M.

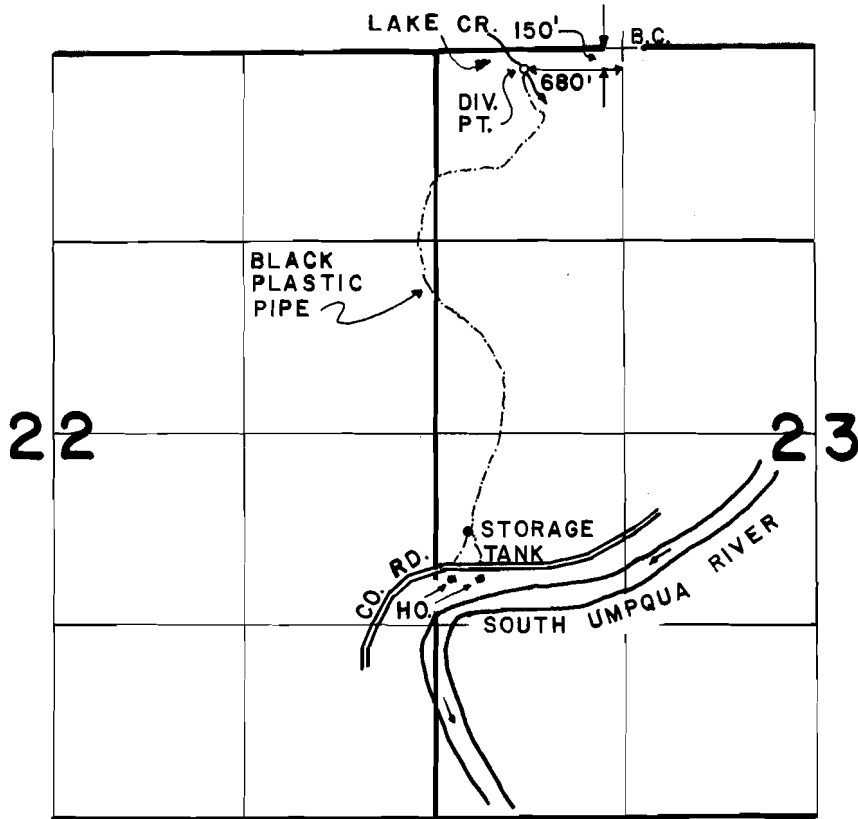

SCALE: 4" = 1 MILE

FINAL PROOF SURVEY UNDER

Application No. 63761... Permit No. 47538...
IN NAME OF

BRIAN SERTIC & WILLIAM E. STEINBACH

Surveyed AUG. 21, 1985, by J. M. SCHMORDE