


T. 27S., R. 58&6W., W.M.

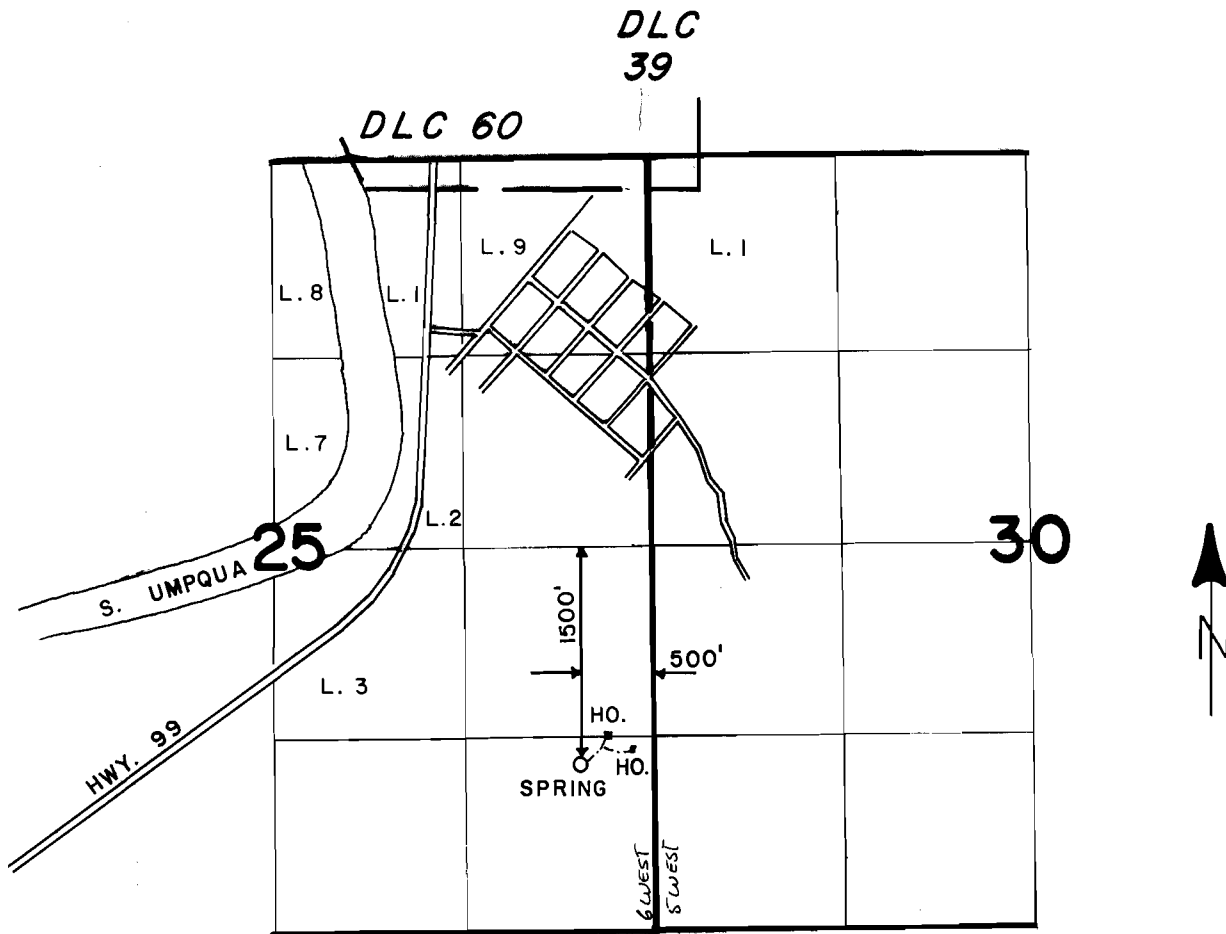

SCALE: 4" = 1 MILE

FINAL PROOF SURVEY
UNDER

Application No. 63781.... Permit No. 46937.....
IN NAME OF

.....**CECIL LYNN RILEY**.....

Surveyed JAN. 7.... 1988., by J.M. SCHMORDE