


T. 7N., R. 4W., W.M.

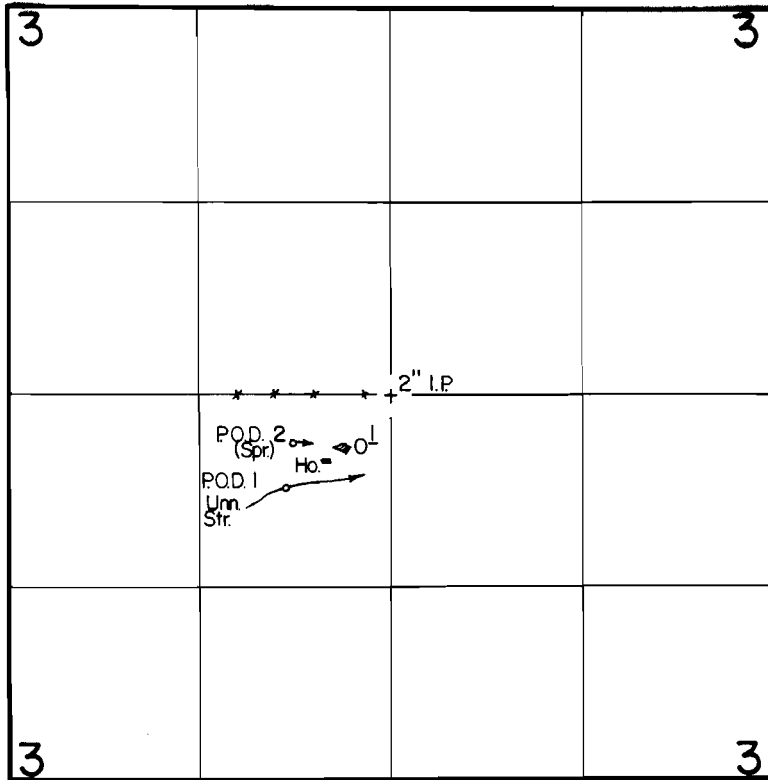

Stream P.O.D. (1) Loc. : 650' S. & 720' W.
 Spring P.O.D. (2) Loc. : 340' S. & 680' W., both from C. 1/4 Cor., Sec. 3.

Scale: 1" = 1320'

FINAL PROOF SURVEY UNDER

Application No. 63784... Permit No. 47219.....
 IN NAME OF

.....SEPPO AALTONEN.....

Surveyed AUG...12... 1986., by .T. Warren.....