


T. 7S., R. 4W., W.M.

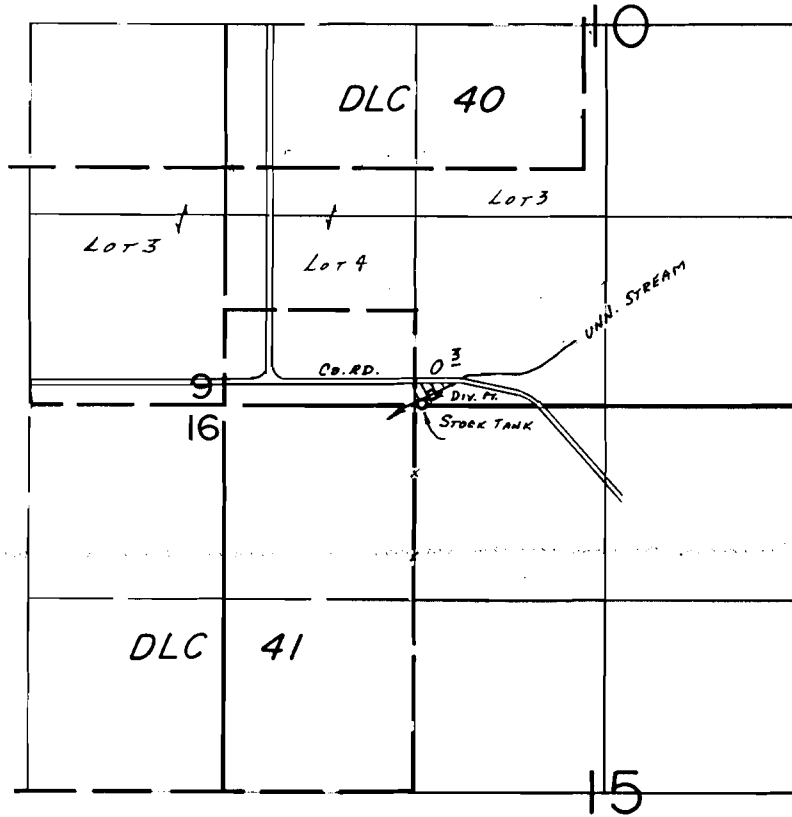

DIV. PT. LOC.: 70' N. & 1430' E. FROM SW COR. SEC. 10.

SCALE: 1" = 1320'

FINAL PROOF SURVEY UNDER

Application No. 63786.. Permit No. 46938.....
IN NAME OF

.....KATHERINE JENSEN.....

Surveyed Sept. 26. 1986, by B.W. BISHOP.....

11/1/87
BWB

41053-178-220L