


T. 30S., R. 5 W., W.M.

SECTION 27

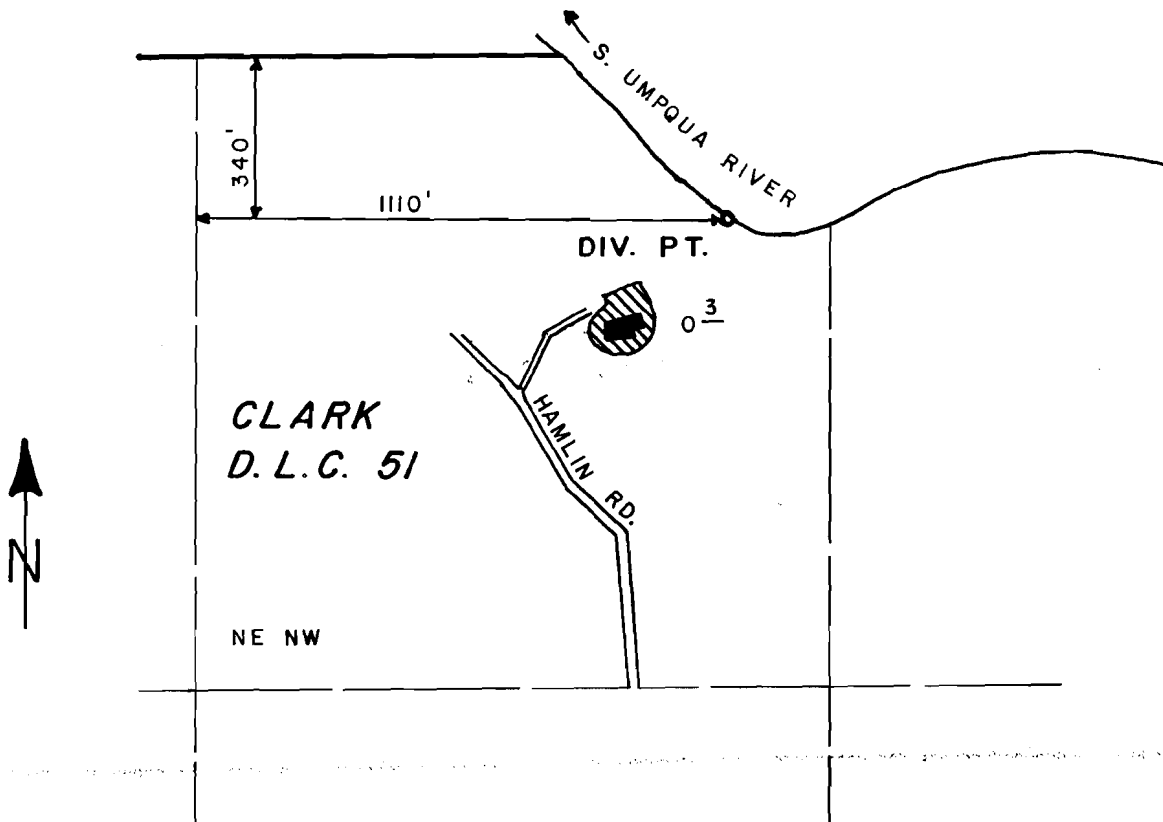

SCALE : 1" = 400'

**FINAL PROOF SURVEY**  
UNDER

Application No. 63850 Permit No. 47009  
IN NAME OF

**BOBBY D. KIMBLE**

Surveyed MAY 29, 1986, by J. M. SCHMORDE