


# T. 25 S., R. 6 W., W.M.

## SECTION 15

STEPHENS  
D.L.C. 50

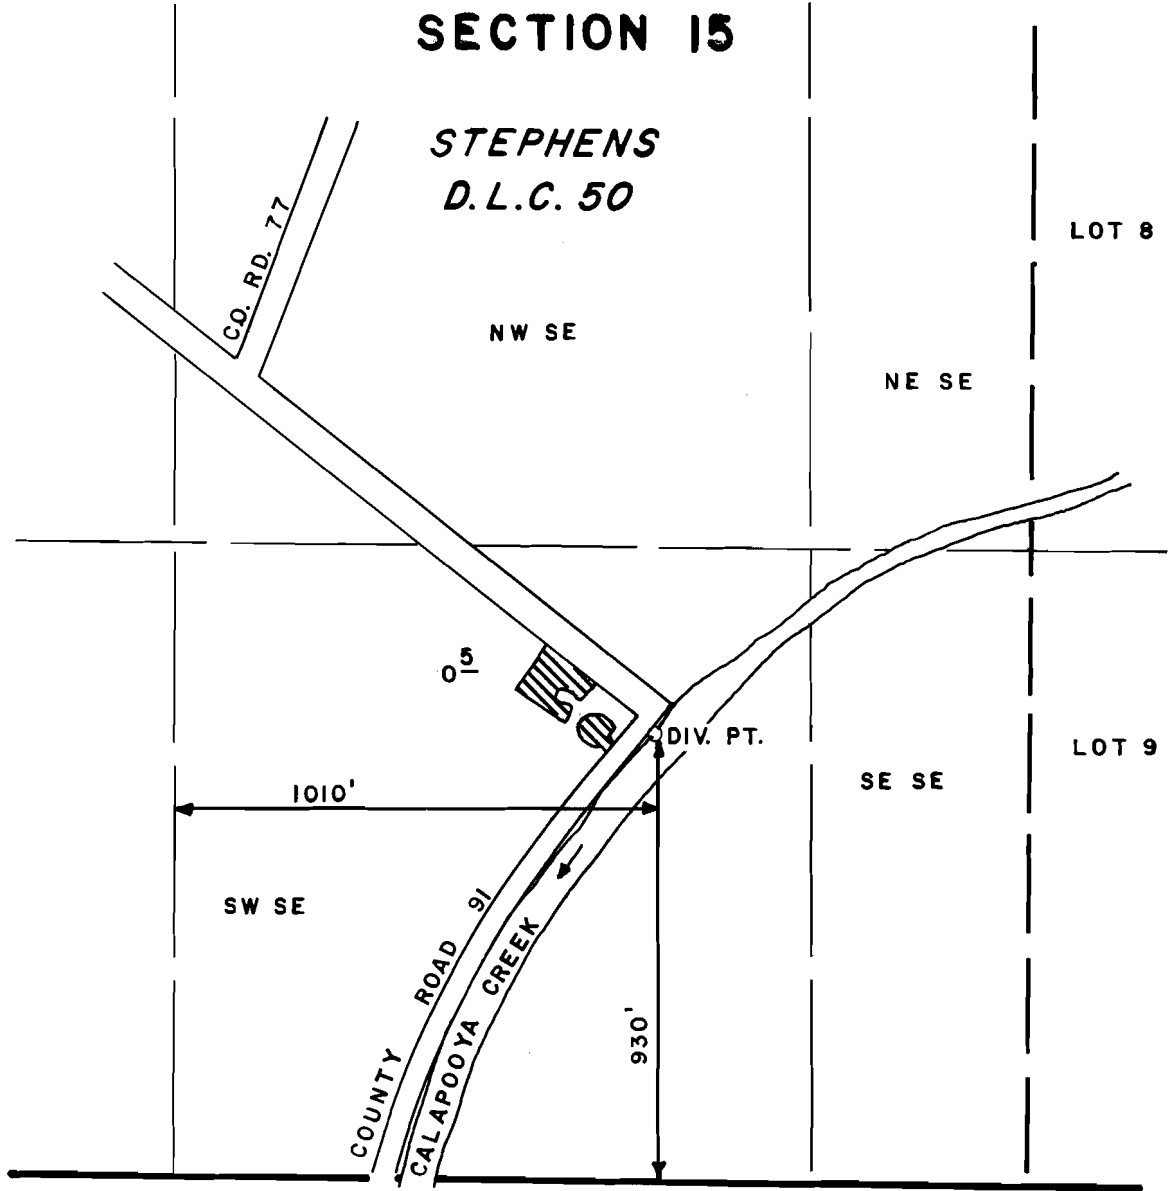

SCALE: 1" = 400'

### FINAL PROOF SURVEY UNDER

Application No. 63937 Permit No. 47015  
IN NAME OF

DENNIS G. BILDERBACK

Surveyed JULY 23 1986, by J. M. SCHMORDE