


# T. 30S., R. 5 W., W.M.

## SECTION 33

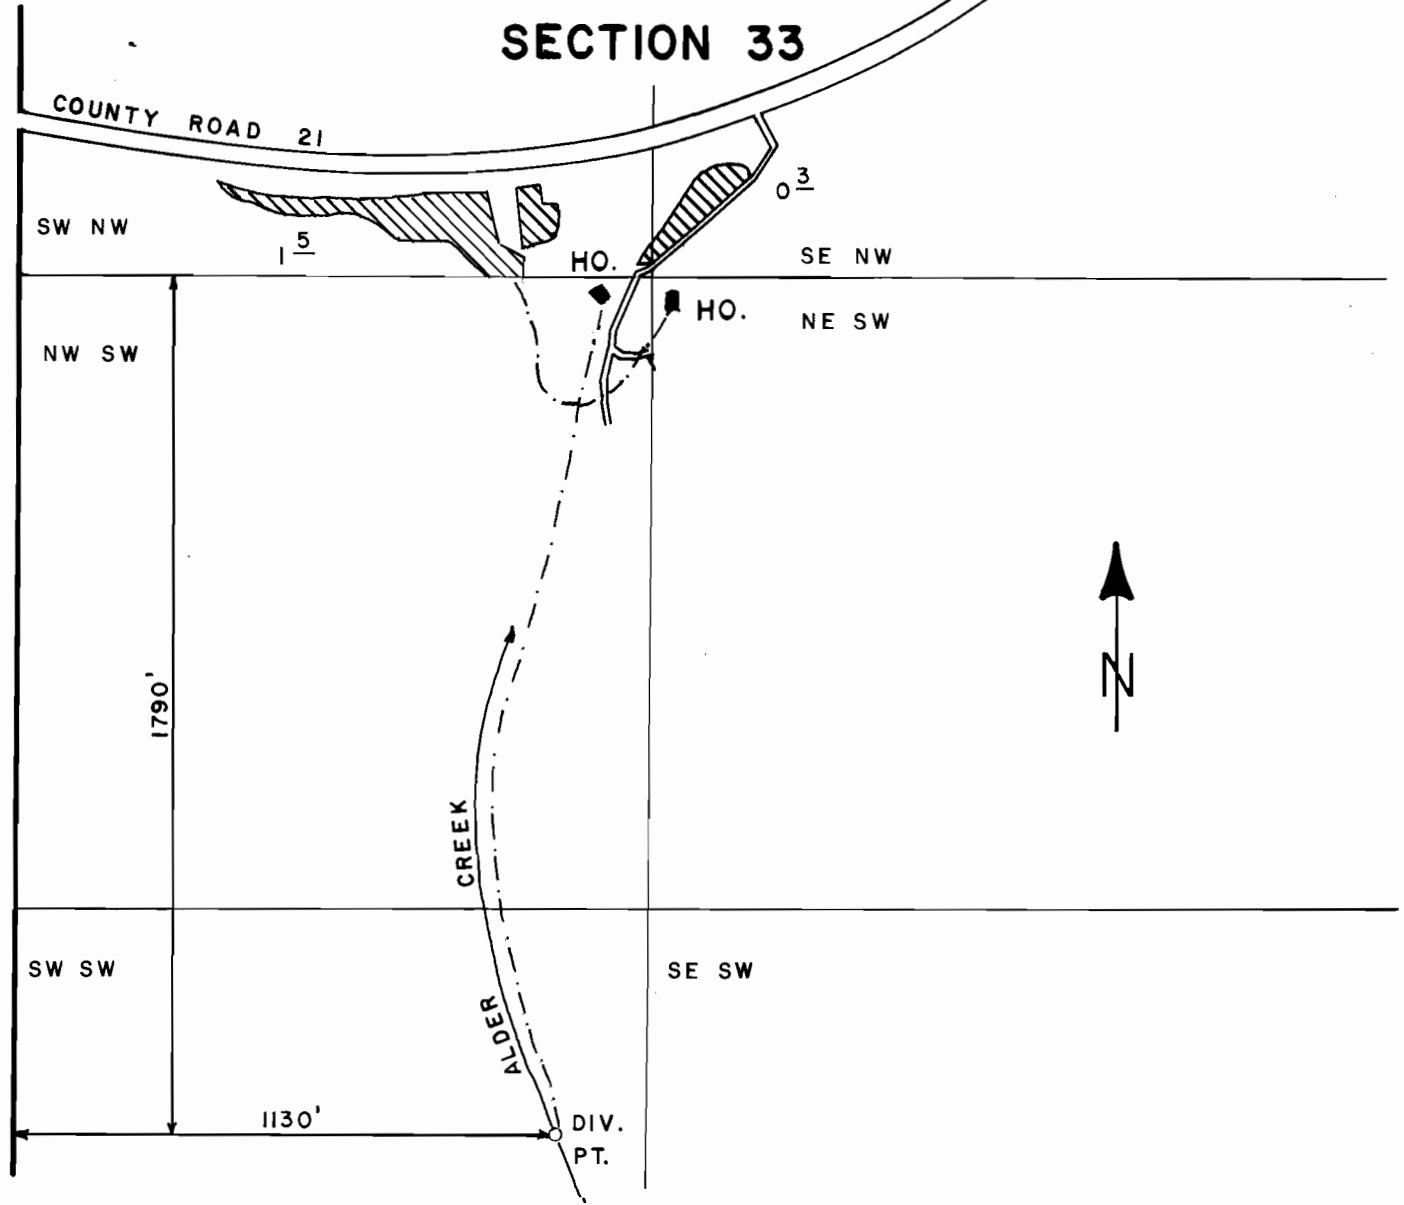

SCALE: 1" = 400'

### FINAL PROOF SURVEY

UNDER

Application No. 63970 Permit No. 47098  
IN NAME OF

**KYLE W. & EVA A. HANKINS**

Surveyed JUNE 11 1986, by J. M. SCHMORDE