


T. 30S., R. 5 W., W.M. SECTION 27

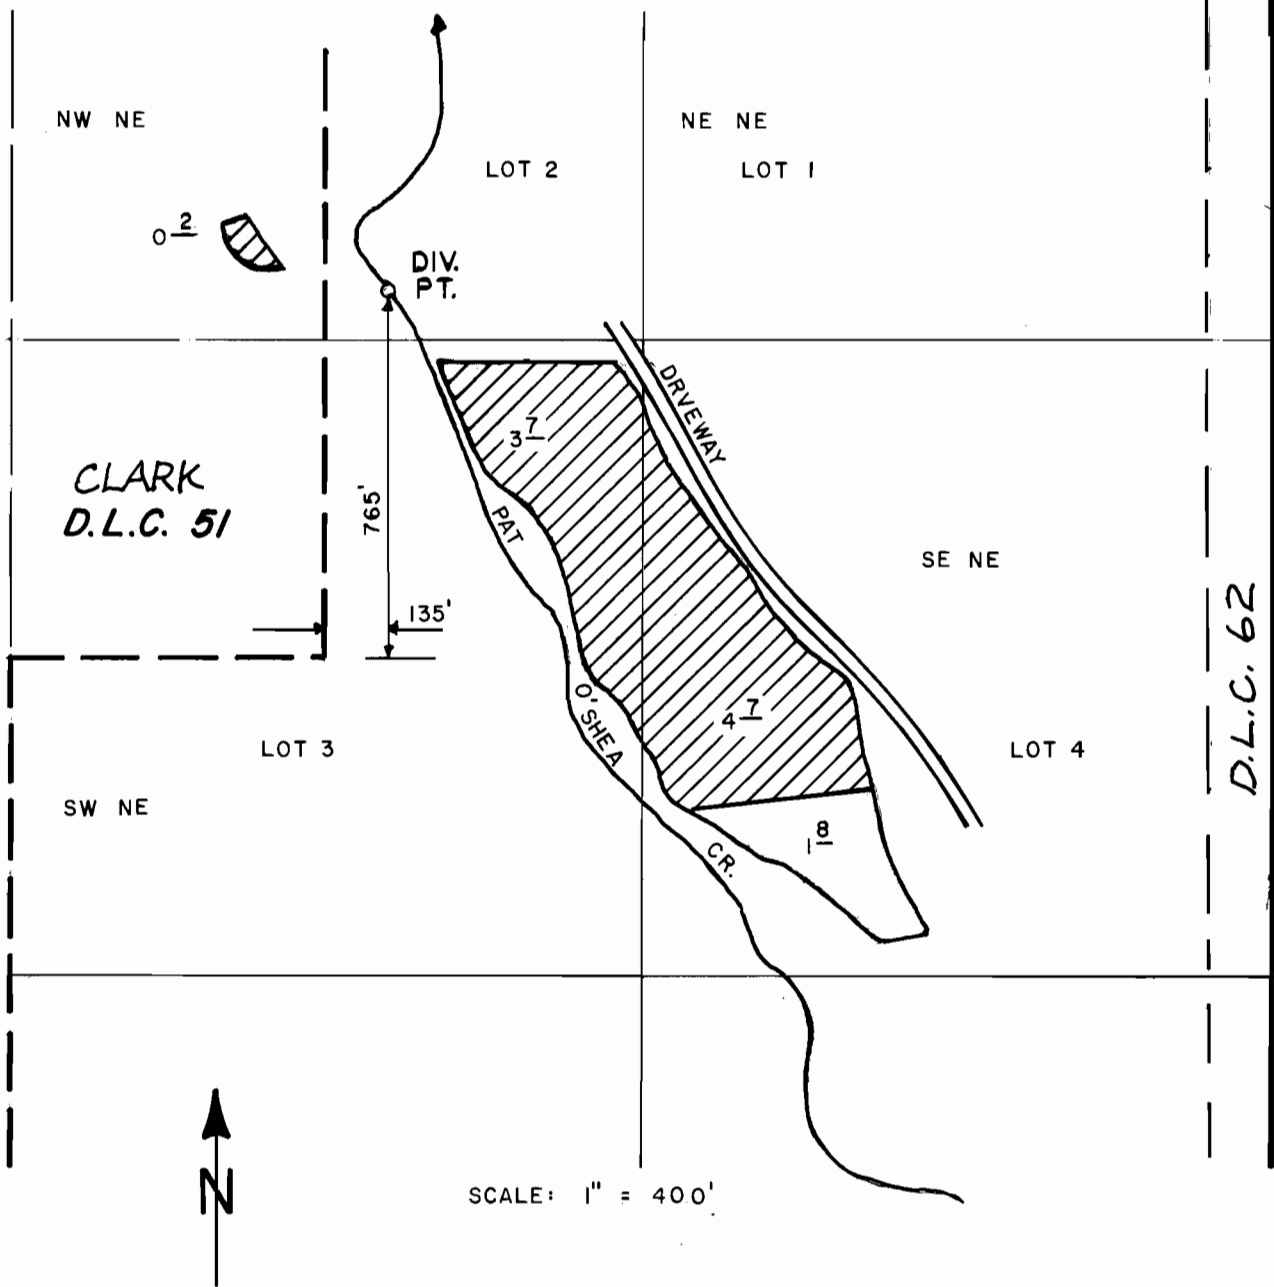

FINAL PROOF SURVEY UNDER

Application No. 64401 Permit No. 47317
IN NAME OF

ESTHER I. FALK

Surveyed JUNE 18, 1986, by J. M. SCHMORDE