


# T. 22 S., R. 7 W., W. M. SECTION 19

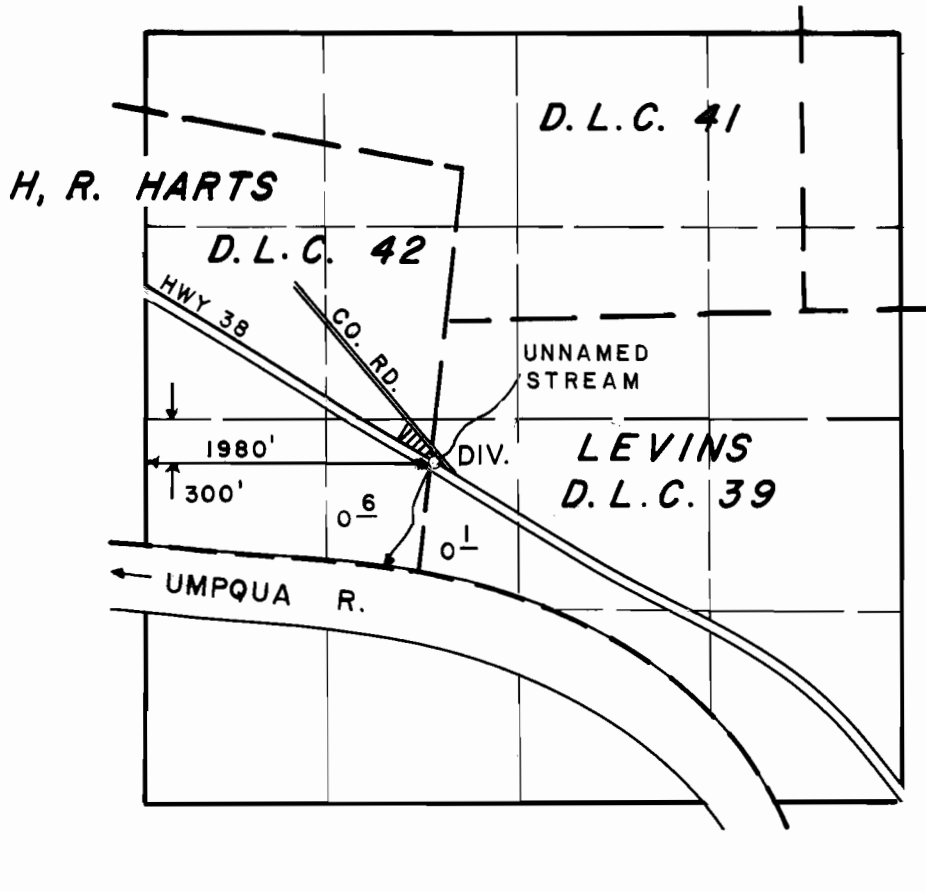

SCALE: 4" = 1 MILE

## FINAL PROOF SURVEY UNDER

Application No. 64402 Permit No. 47140.....  
IN NAME OF

**JOHN C. ABRAHAM**

Surveyed AUG. 25 1987, by J. M. SCHMORDE