


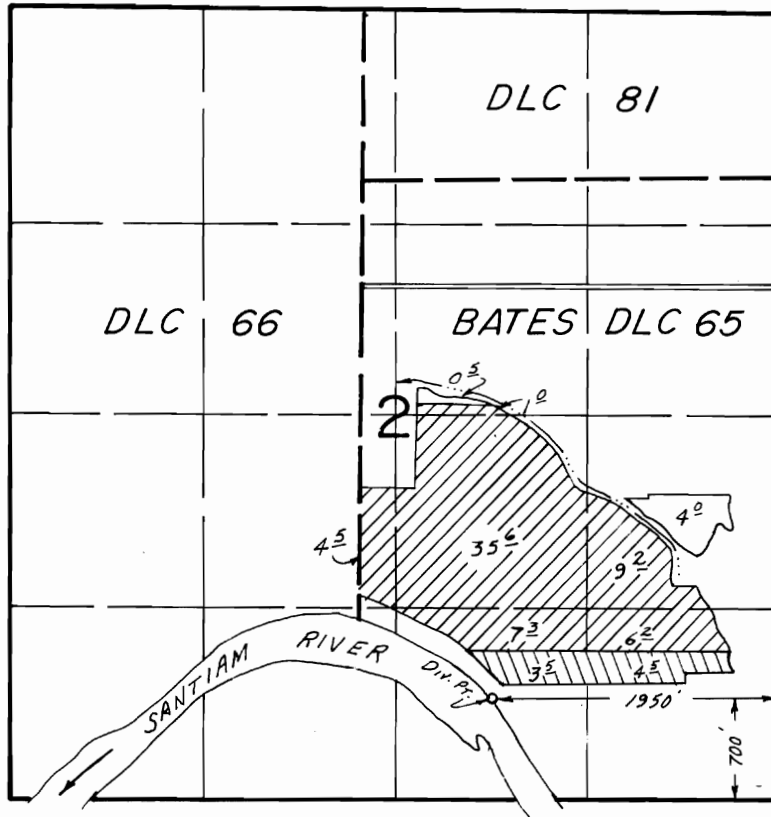

T. 10S., R. 3W., W.M.



SCALE: 1" = 1320'

FINAL PROOF SURVEY UNDER

Transfer No. 5246 

Application No. 65079.. Permit No. 47809 

IN NAME OF

.....ARTHUR BRYCE PAGE.....

Surveyed May 1..... 1985, by P.R. PAGTER.....
Aug. 22 1985 B.W. BISHOP