


# T. 26 S., R. 5 W., W.M.

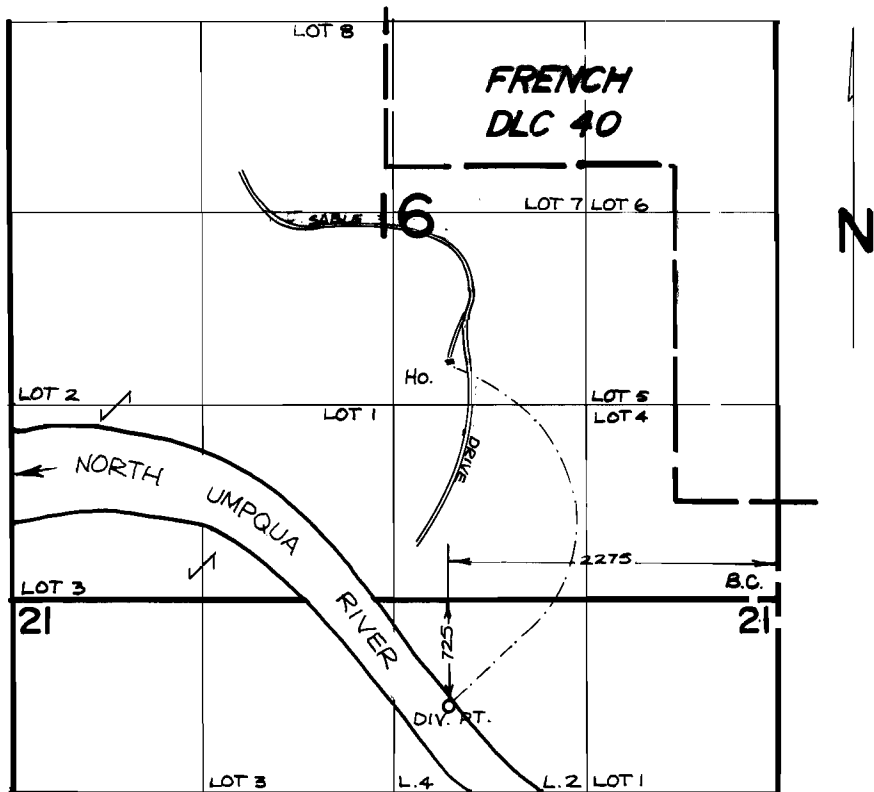

SCALE : 4" = 1 MILE

## FINAL PROOF SURVEY UNDER

Application No. ..65169... Permit No. ....4.7838...  
IN NAME OF

.....CHARLES..H..&..IONE..W..KLOTZ....

Surveyed ..OCT...9,.. 19.86., by ..J.M..SCHMORDE.