




T. 2 S., R. 2 E., W.M.

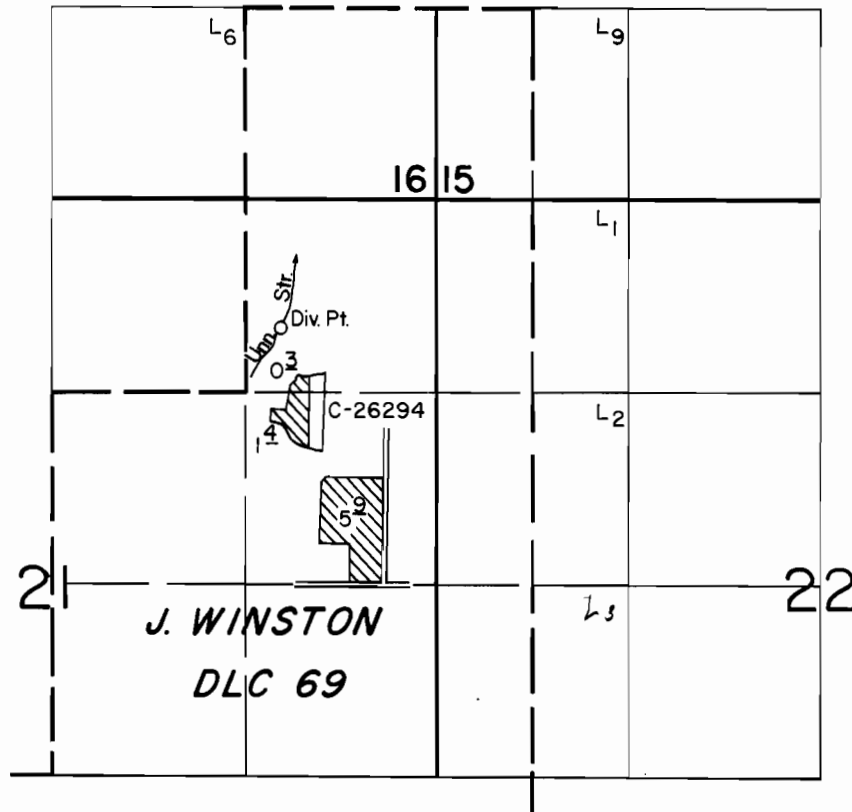

DIV. PT. LOC: 2200' S. & 1740' W. FROM NE. CORNER J. WINSTON DLC. 69

SCALE: 1" = 1320'

FINAL PROOF SURVEY
UNDER

Application No. 65189... Permit No. 47844...
IN NAME OF

MONTE LEE SELLERS

Surveyed AUG. 26, 1986, by T. WARREN