


T. 39 S., R. 3 W., W. M.

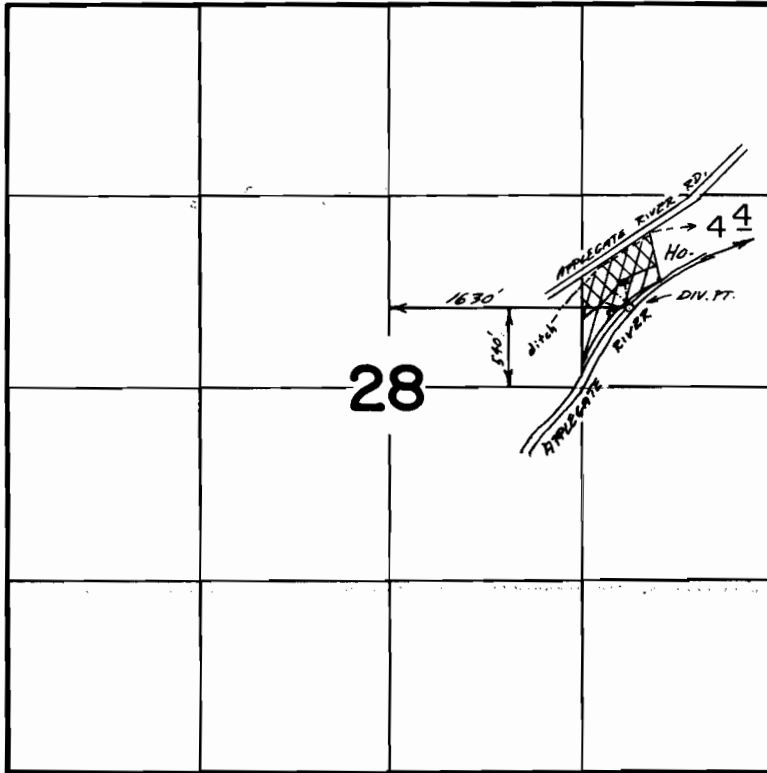

Scale 1" = 1320'



- ▨ 1926 = 2 ⁵/₈ Acres } Pri
- ▧ 1983 = 1 ⁹/₈ Acres } Pri
- " = 4 ¹/₄ Ac. Suppl.

FINAL PROOF SURVEY
UNDER

Transfer No. 5310

Application No. 65253 Permit No. 47895

IN NAME OF

JOHN C. NELSON

Surveyed Nov. 10, 1987, by B.S. JAMES