


T. 28S., R. 6W., W.M.

SECTIONS 32 & 33

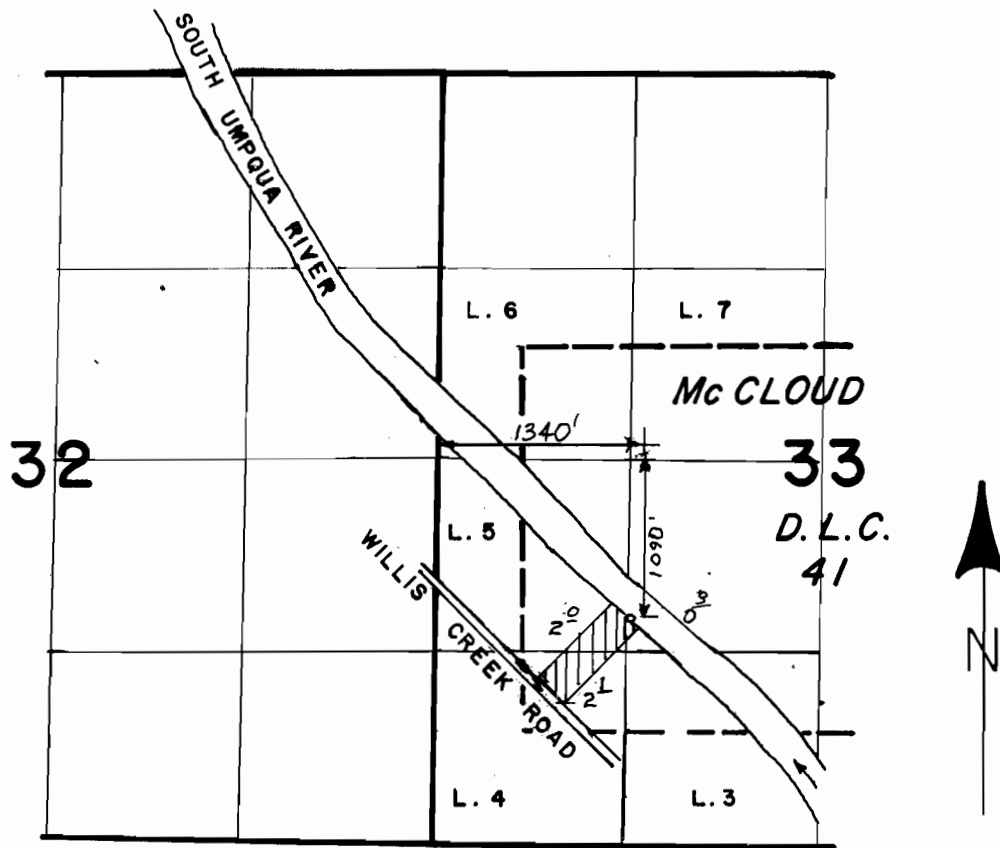

SCALE: 4" = 1 MILE

FINAL PROOF SURVEY UNDER

Application No. 65388.. Permit No. 47704.....
IN NAME OF

NORMAN DUANE SASSER

Surveyed MAY II..... 1987, by J. M. SCHMORDE