


T.21S.,R.46&47E.,W.M.

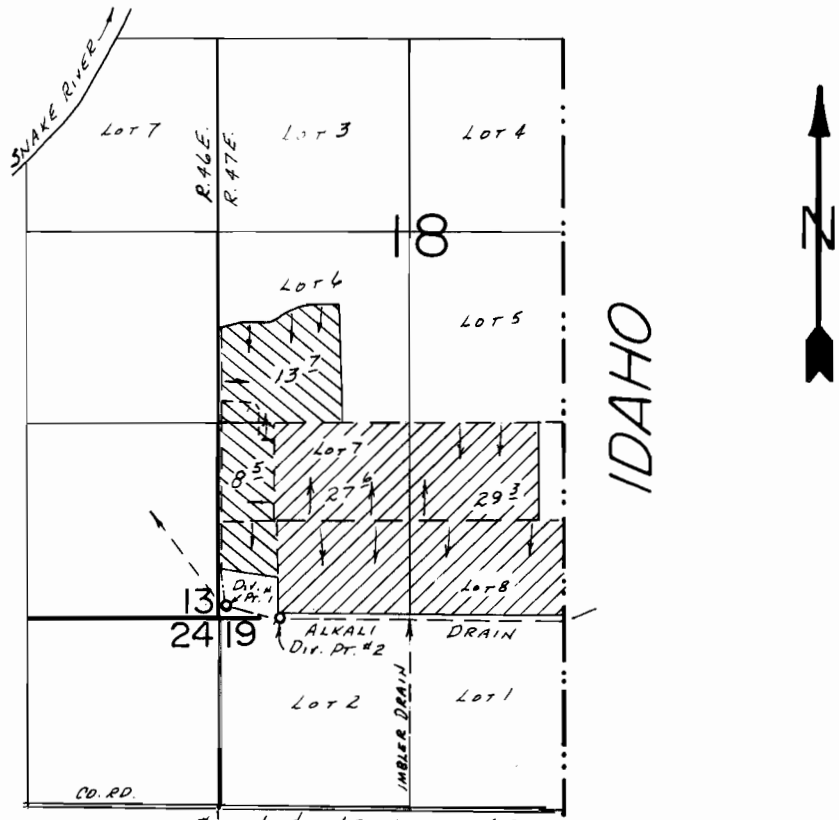

DIV. PTS. LOC.: #1-30'N. & 60'E., #2-420'E., BOTH FROM SW COR SEC. 18.

 PACKWOOD
 BENNETT

SCALE: 1" = 1320'

FINAL PROOF SURVEY
UNDER

Application No. 65509.. Permit No. 47981.....
IN NAME OF

PACKWOOD & ALAN & LINDA BENNETT

Surveyed Mar. 26. 19.86, by L.M.TOLL.....

3/5/87
BBC-3KK-64