


Application No. 65524  
Permit No. 47983

RECEIVED  
AUG 10 1983  
WATER RESOURCES DEPT.  
SALEM, OREGON

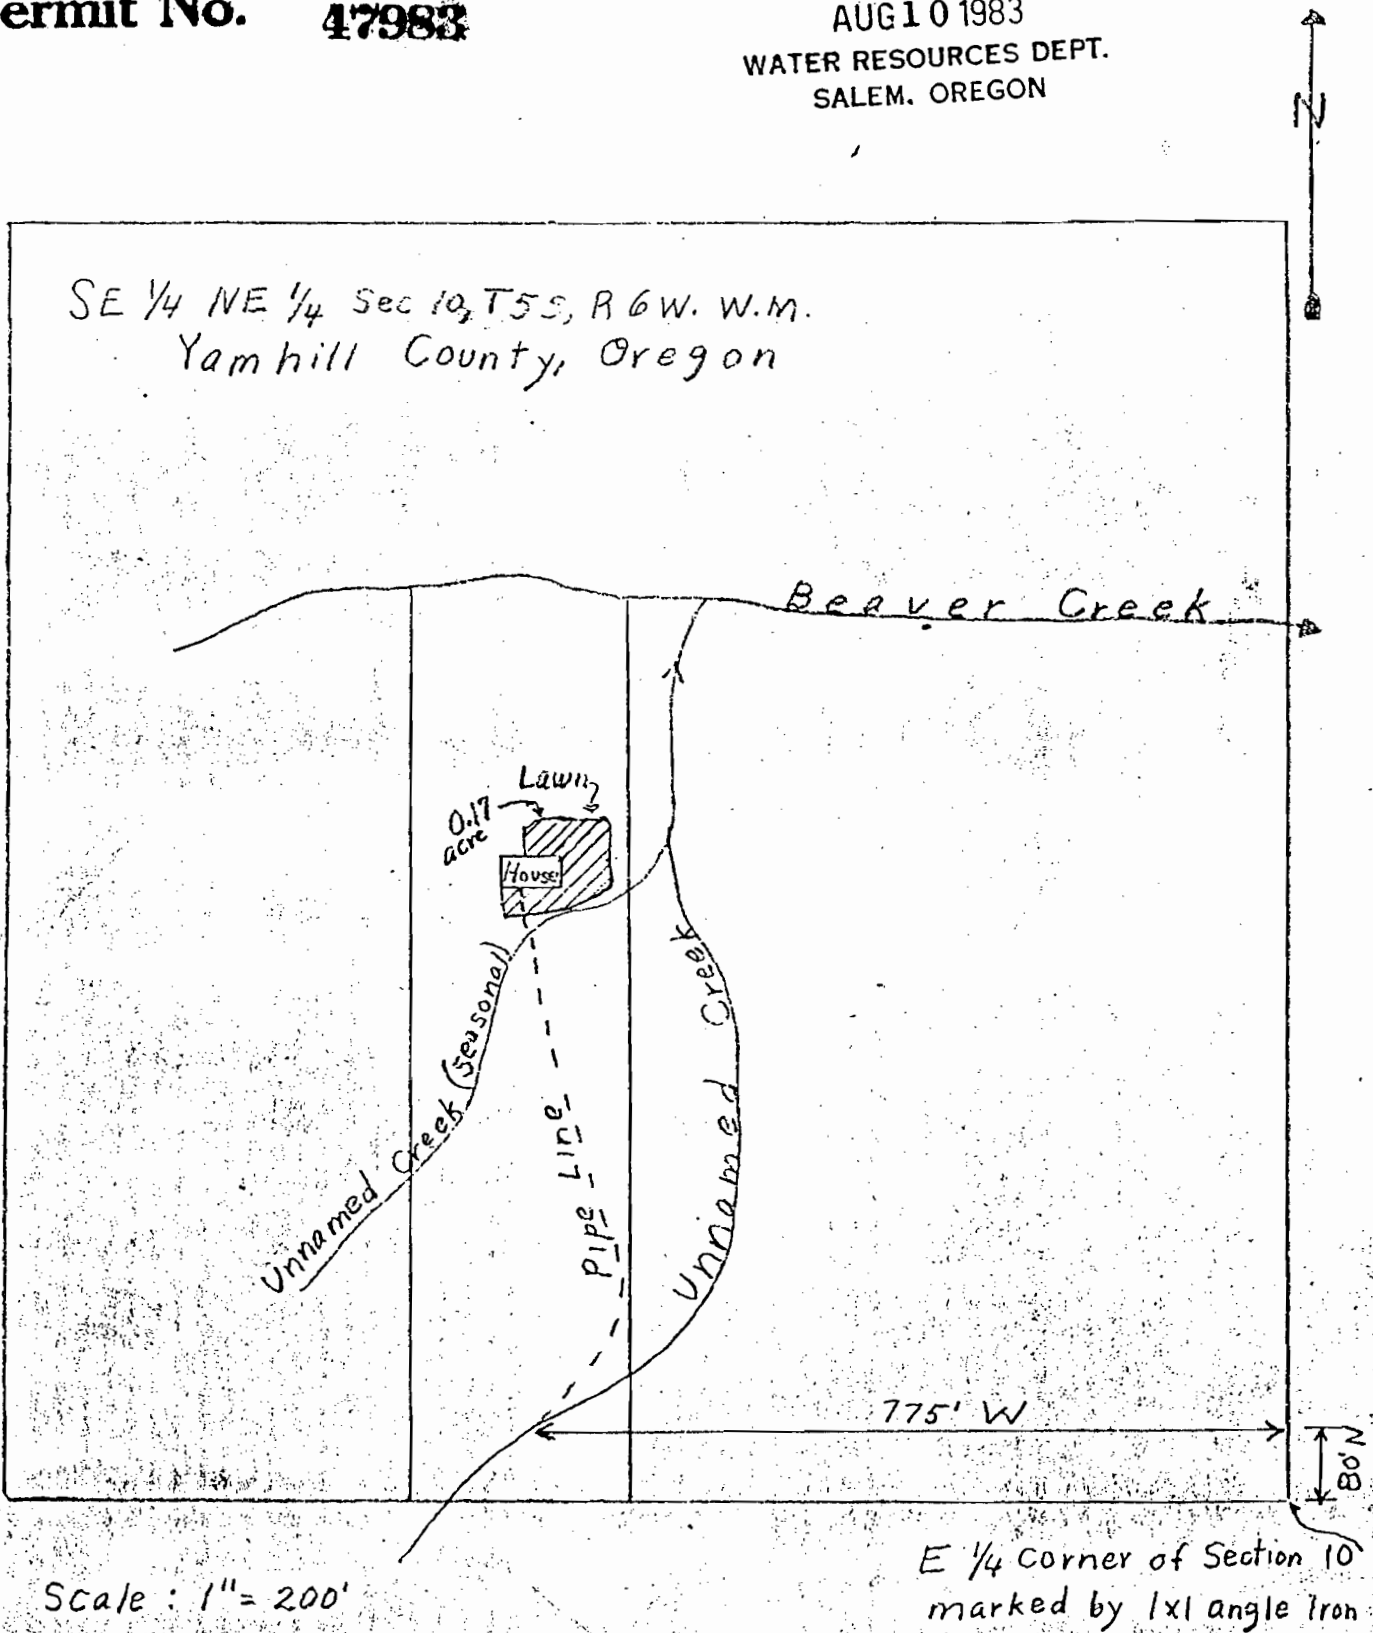

Scale : 1" = 200'

E 1/4 Corner of Section 10  
marked by 1x1 angle iron