


T.37S., R.9W., W.M.

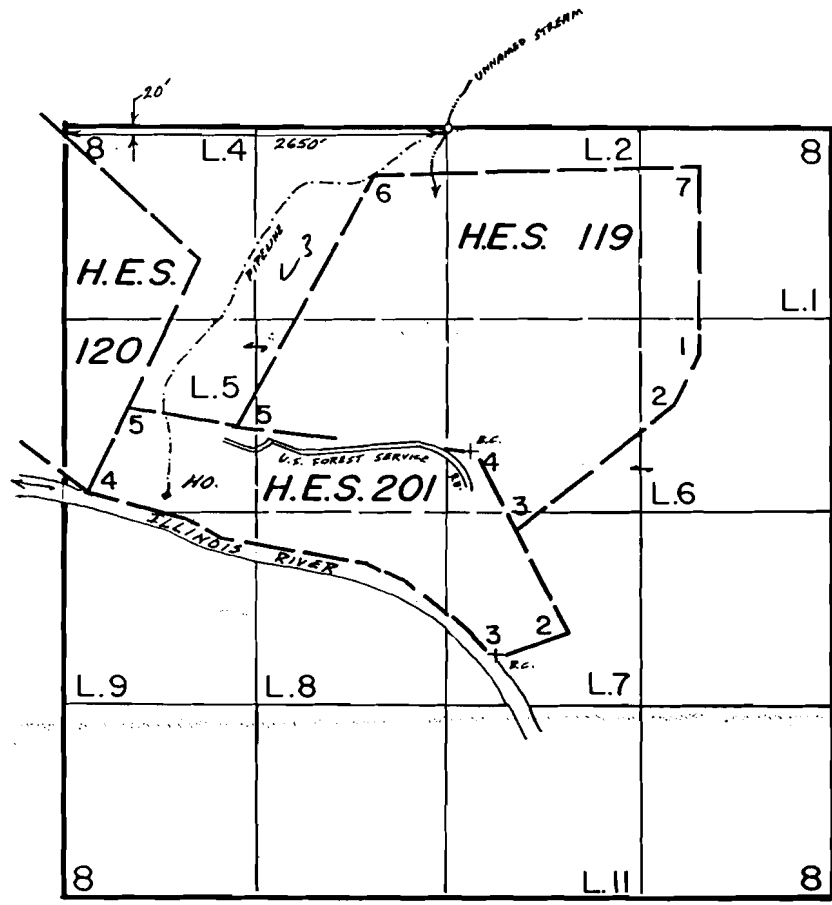

Scale 1" = 1320'



FINAL PROOF SURVEY UNDER

Application No. 65585. Permit No. 48068....
IN NAME OF

.....ROLF SOMMER.....

Surveyed Nov. 17, 1987, by B.S. JAMES.....