


T. 36 S., R. 5 W., W. M.

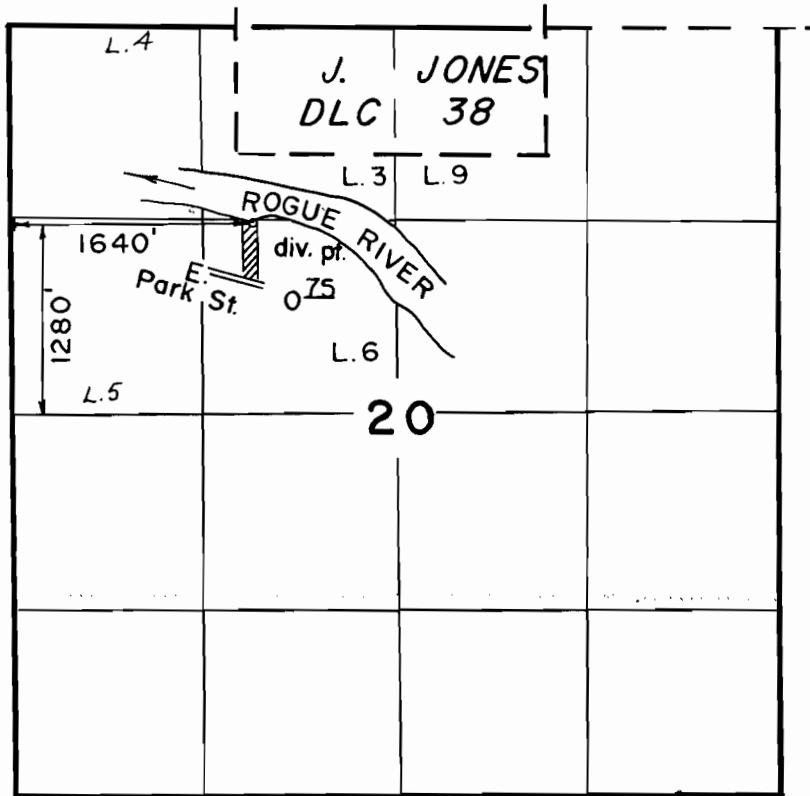

Scale: 1" = 1320'

FINAL PROOF SURVEY
UNDER

Application No. 66051 Permit No. 48052
IN NAME OF

DOROTHY Y. PATTINSON

Surveyed AUG. 6 1987, by B. S. JAMES