


T. 25 S., R. 7 W., W.M.
SECTIONS 29 AND 30.

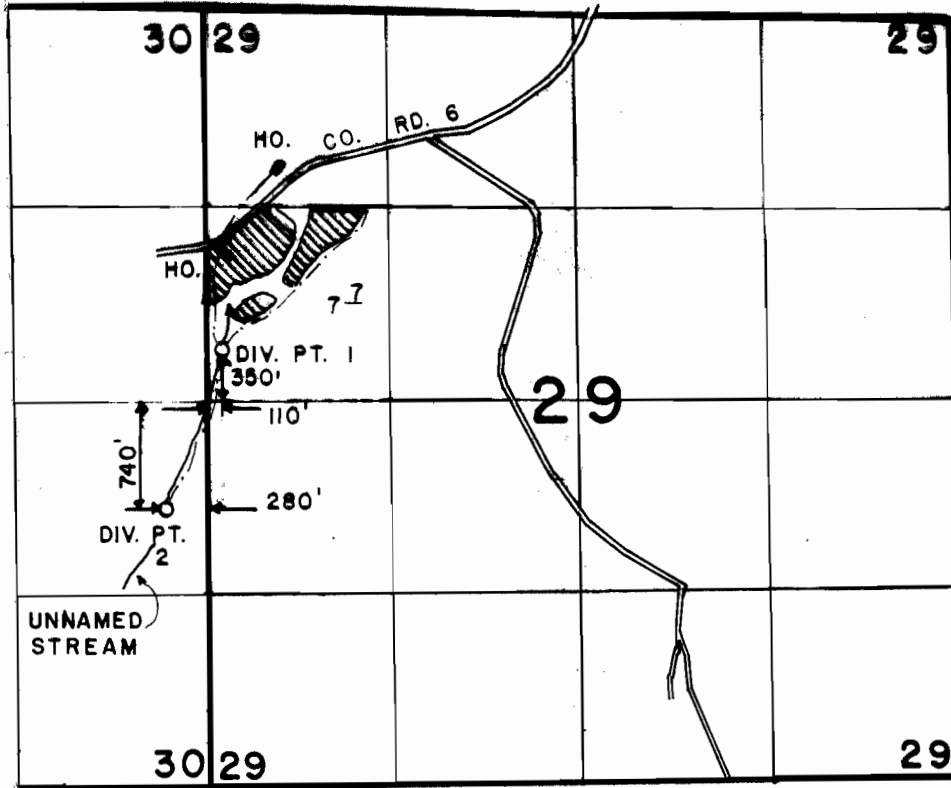

SCALE: 4" = 1 MILE

FINAL PROOF SURVEY
UNDER

Application No. 66412... Permit No. 48060.....
IN NAME OF

H.B. AND MELBA L. GERMOND

Surveyed OCT. 13... 1987., by J.M. SCHMORDE