

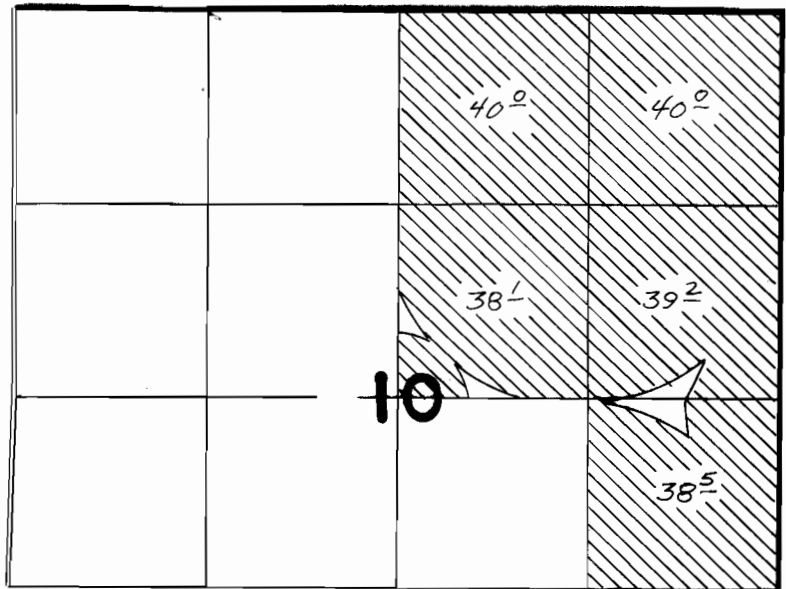


T. 4N., R. 26E., W.M.

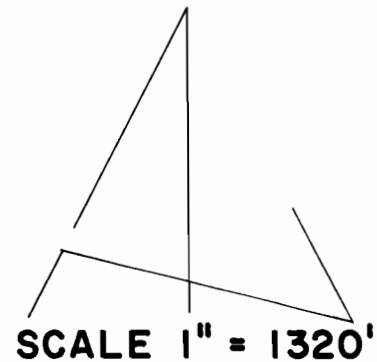

T. 5N., R. 26E., W.M.

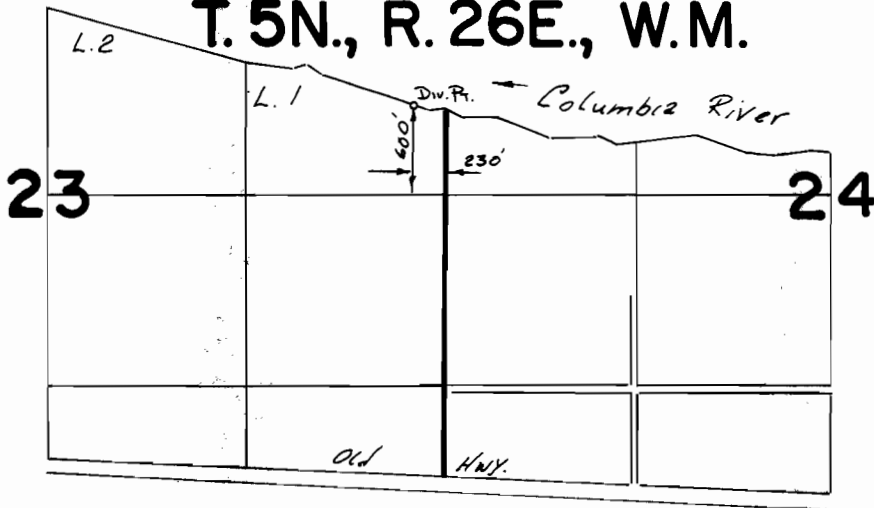

FINAL PROOF SURVEY UNDER

Application No. **66720** Permit No. **48119**.....
IN NAME OF

.....**DENNIS B. LOGAN**.....

Surveyed 10-23 1987, by V.L. Church.....