


T.9S., R.3E., W.M.

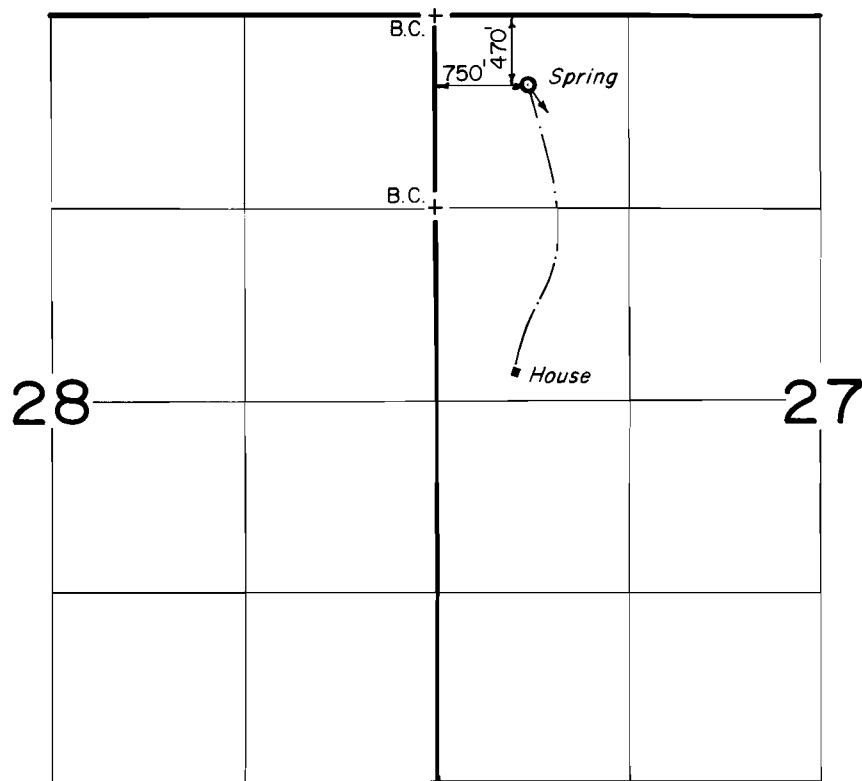

FINAL PROOF SURVEY
UNDER

Application No. 58055 Permit No. 43820
IN NAME OF

EDWIN DEE & JOYCE E. FAULKNER

Surveyed OCT. 4, 1979, by *MB*