

FINAL PROOF SURVEY MAP

IN THE NAME OF : WILLIAM L. AND MARIE F. SCHNELLER

S19, T26S, R4W, WM



LOT 32 EAGLE POINT ESTATES

APPLICATION 69237 PERMIT 50138



THE POINT OF DIVERSION IS LOCATED 570 FEET NORTH
AND 460 FEET EAST FROM THE WEST 1/4 CORNER OF
SECTION 19.

1" = 200'

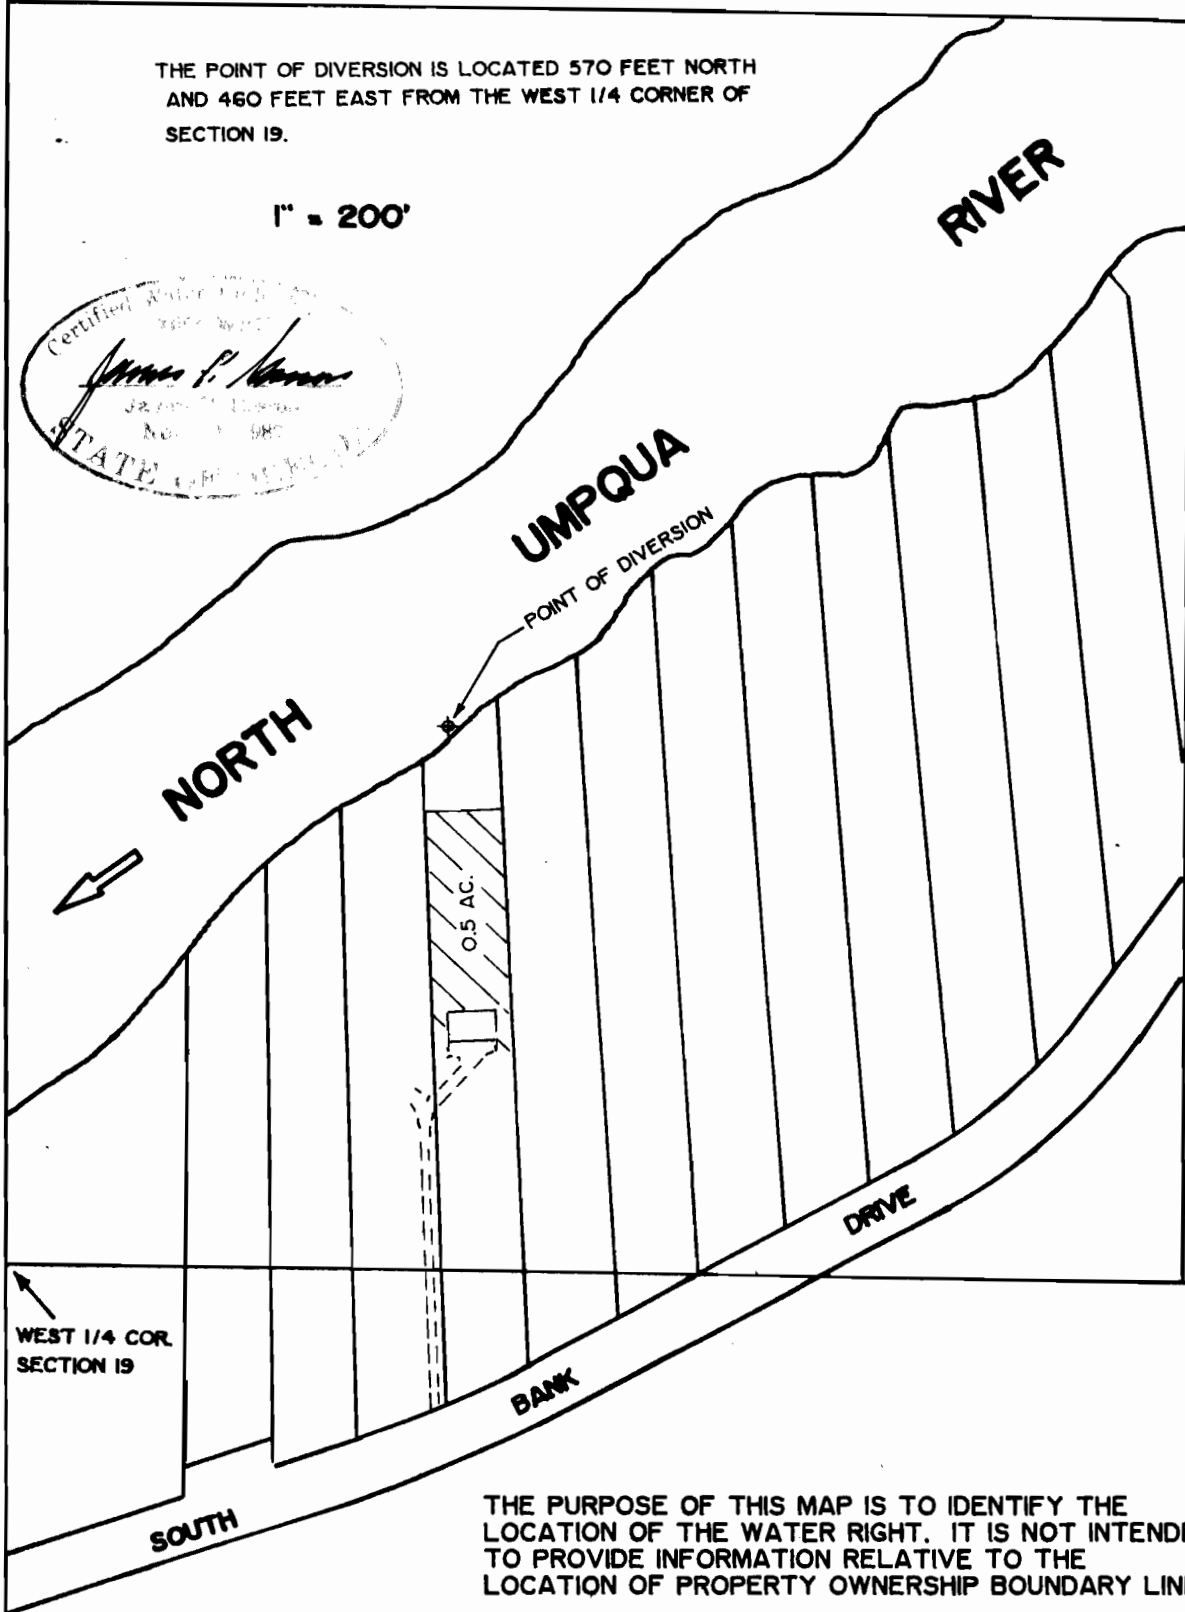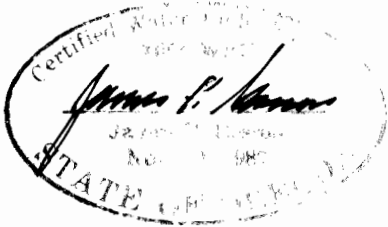

THE PURPOSE OF THIS MAP IS TO IDENTIFY THE
LOCATION OF THE WATER RIGHT. IT IS NOT INTENDED
TO PROVIDE INFORMATION RELATIVE TO THE
LOCATION OF PROPERTY OWNERSHIP BOUNDARY LINES.