


T.36S.,R.7W.,W.M.

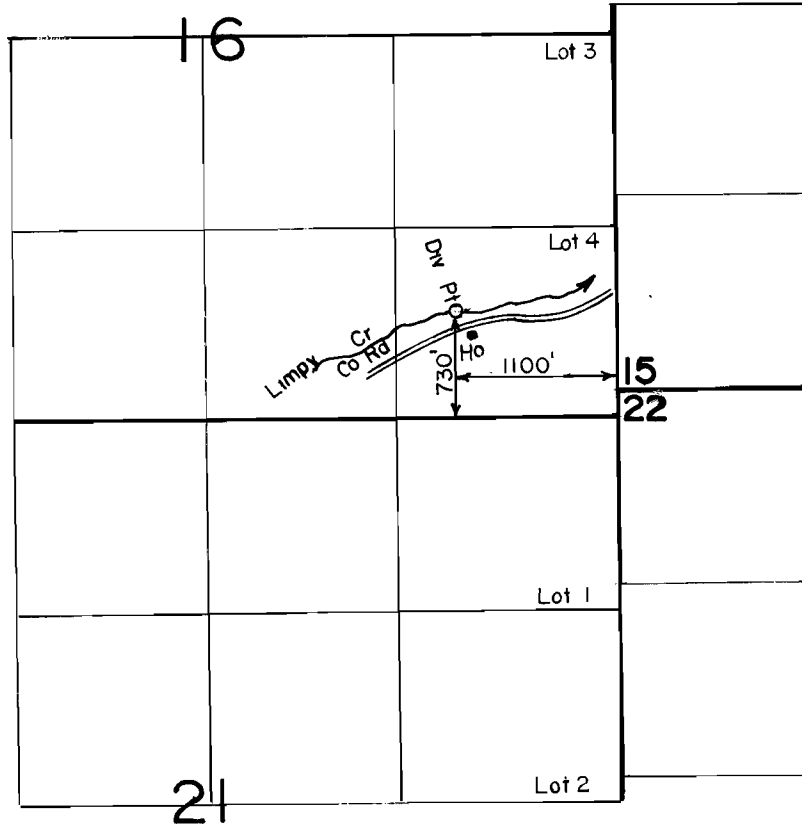

SCALE: 1"=1320'

**FINAL PROOF SURVEY**  
**UNDER**

Application No. 37171... Permit No. 27682.....  
IN NAME OF

.....JEROME C. & IRENE M. HARMON.....

Surveyed JULY 15... 1963., by R.H. JACKSON...