


T. 39S., R. 35E., W. M.

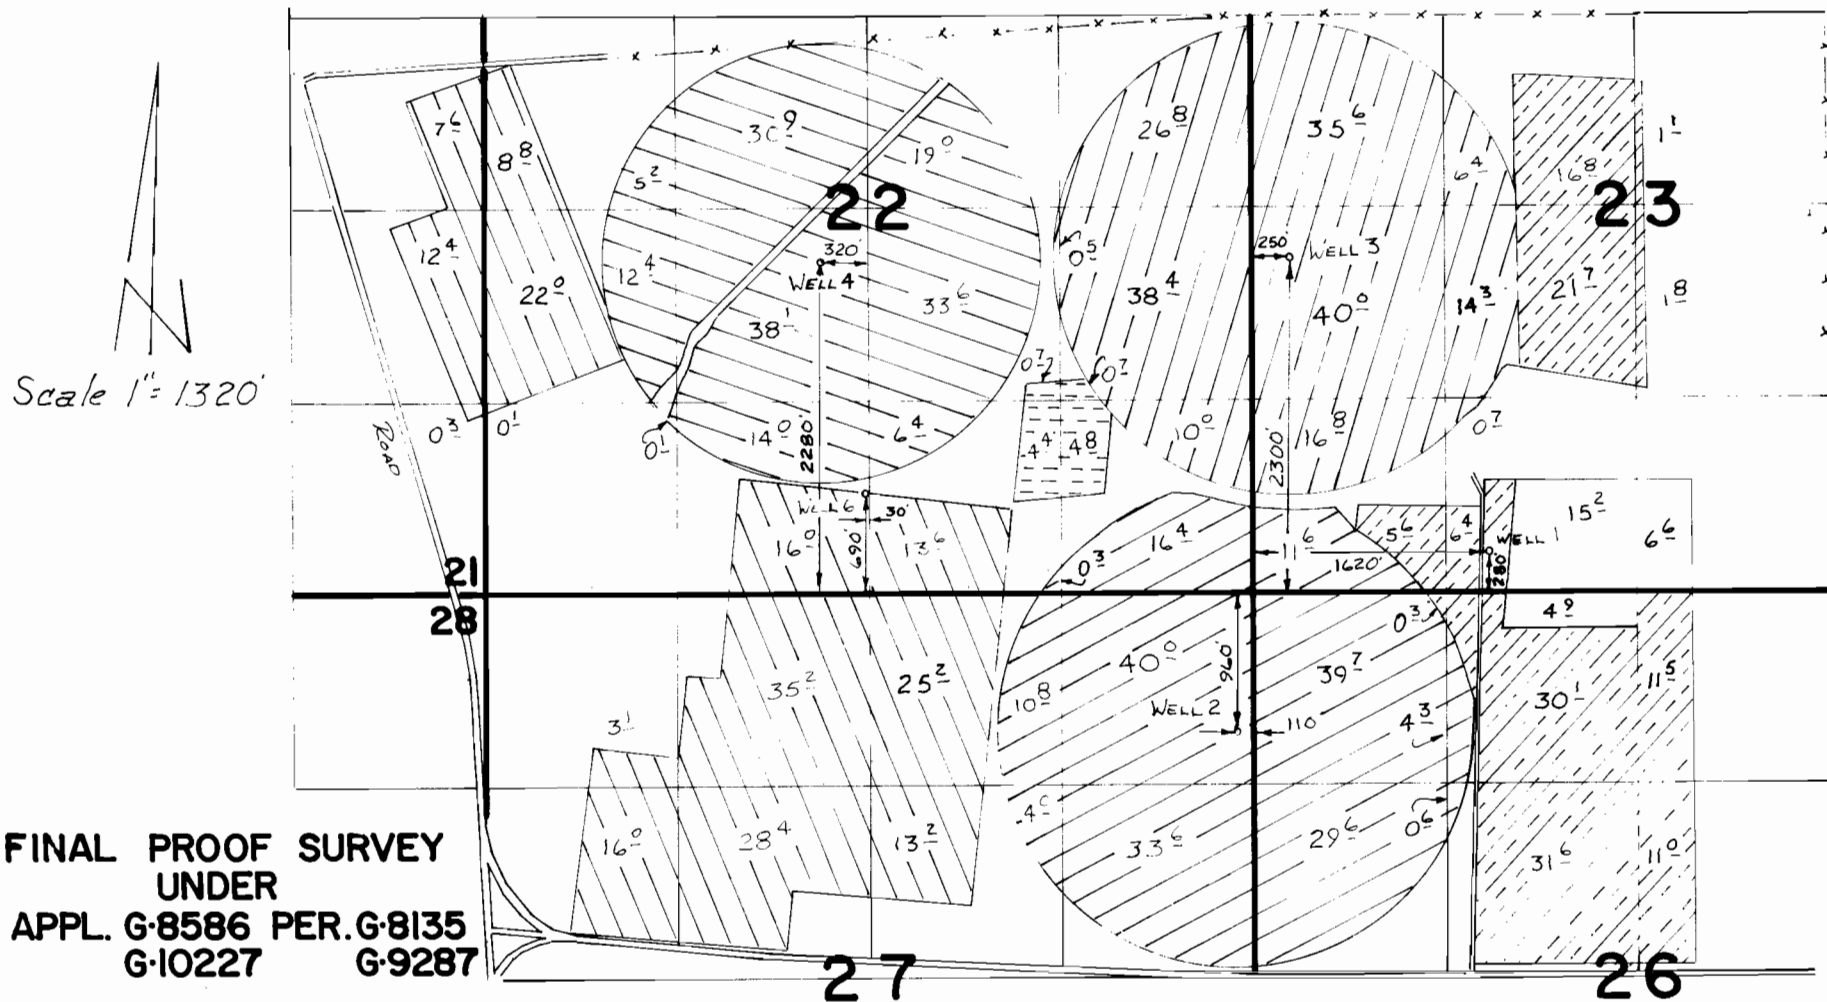

FINAL PROOF SURVEY
UNDER
APPL. G-8586 PER. G-8135
G-10227 G-9287

IN NAME OF

WALLY COLEMAN



WELL #1 PRIM.
WELL #2 PRIM.
WELL #3 PRIM. PER. G-8135
WELL #4 PRIM.
WELL #6 PRIM.

WELL #6 PRIM. PER. 9287

Surveyed 7-16, 1988, by V.L. Church

41025-579-137L, 138L

1 OF 2
12-5-88 VLC

90684