



T.7S.,R.18&2W.,W.M.

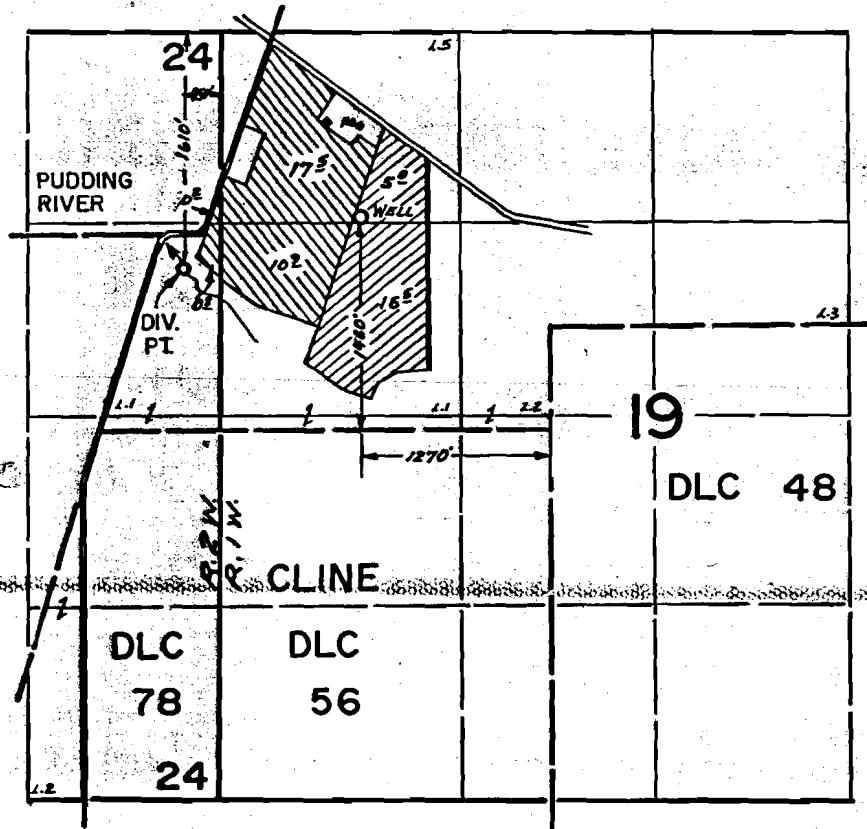

 PRIMARY - G-9032, SUPPLEMENTAL-61939

 PRIMARY - 57718, SUPPLEMENTAL-G-9032

FINAL PROOF SURVEY
UNDER

G-9032 G-8391
57718 43447
Application No. 61939 Permit No. 46278
IN NAME OF

.....DONALD W. MANTIE.....

Surveyed Aug. 13, 1981, by L. TOLL
Aug. 16, 1985, by B. W. BISHOP