


T.17S.,R.5W.,W.M

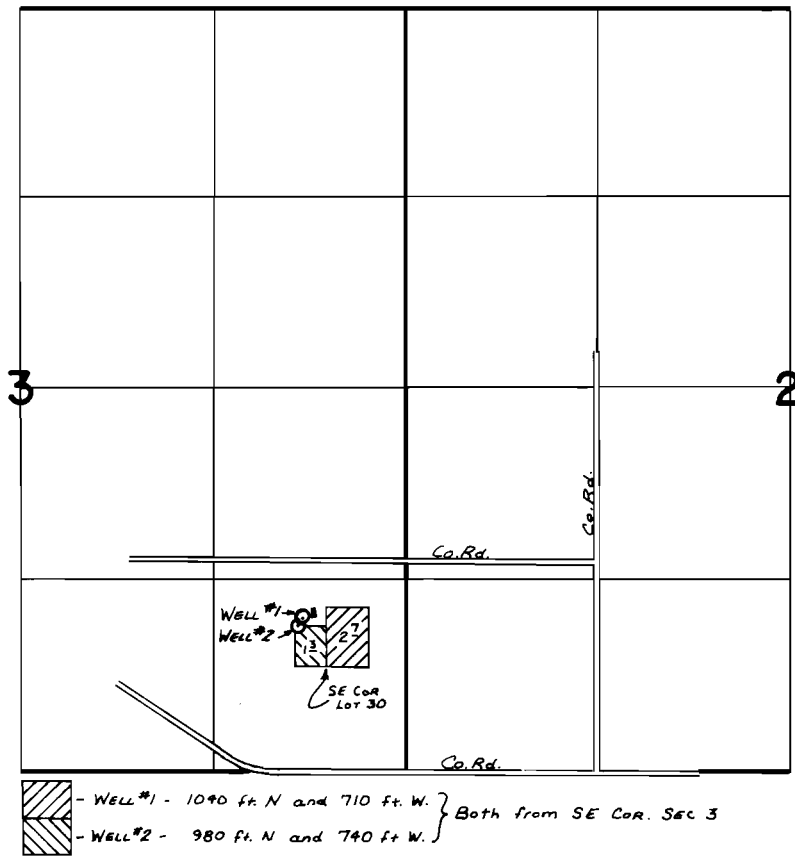

FINAL PROOF SURVEY UNDER

Application No. G:9337. Permit No. G:9300.....
IN NAME OF

ROBERT G. HARP

Surveyed Sept. 15, 1981., by S. C. BROWN.....