


T.21S., R.10E., W.M.

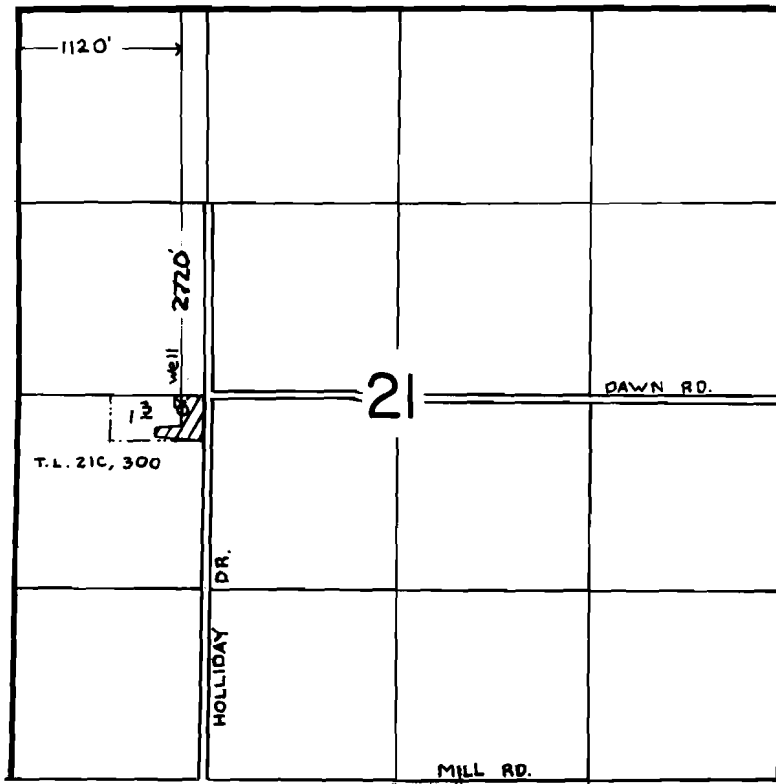

SCALE: 1" = 1320'

**FINAL PROOF SURVEY**  
UNDER

Application No. G-10079 Permit No. G-9340.....  
IN NAME OF

**RICHARD D. JOHNSON**

Surveyed MAY 27.... 1986., by M.J. MATTICK.....

*Cert. # 64435*