


T. 39S., R. 35E., W. M.

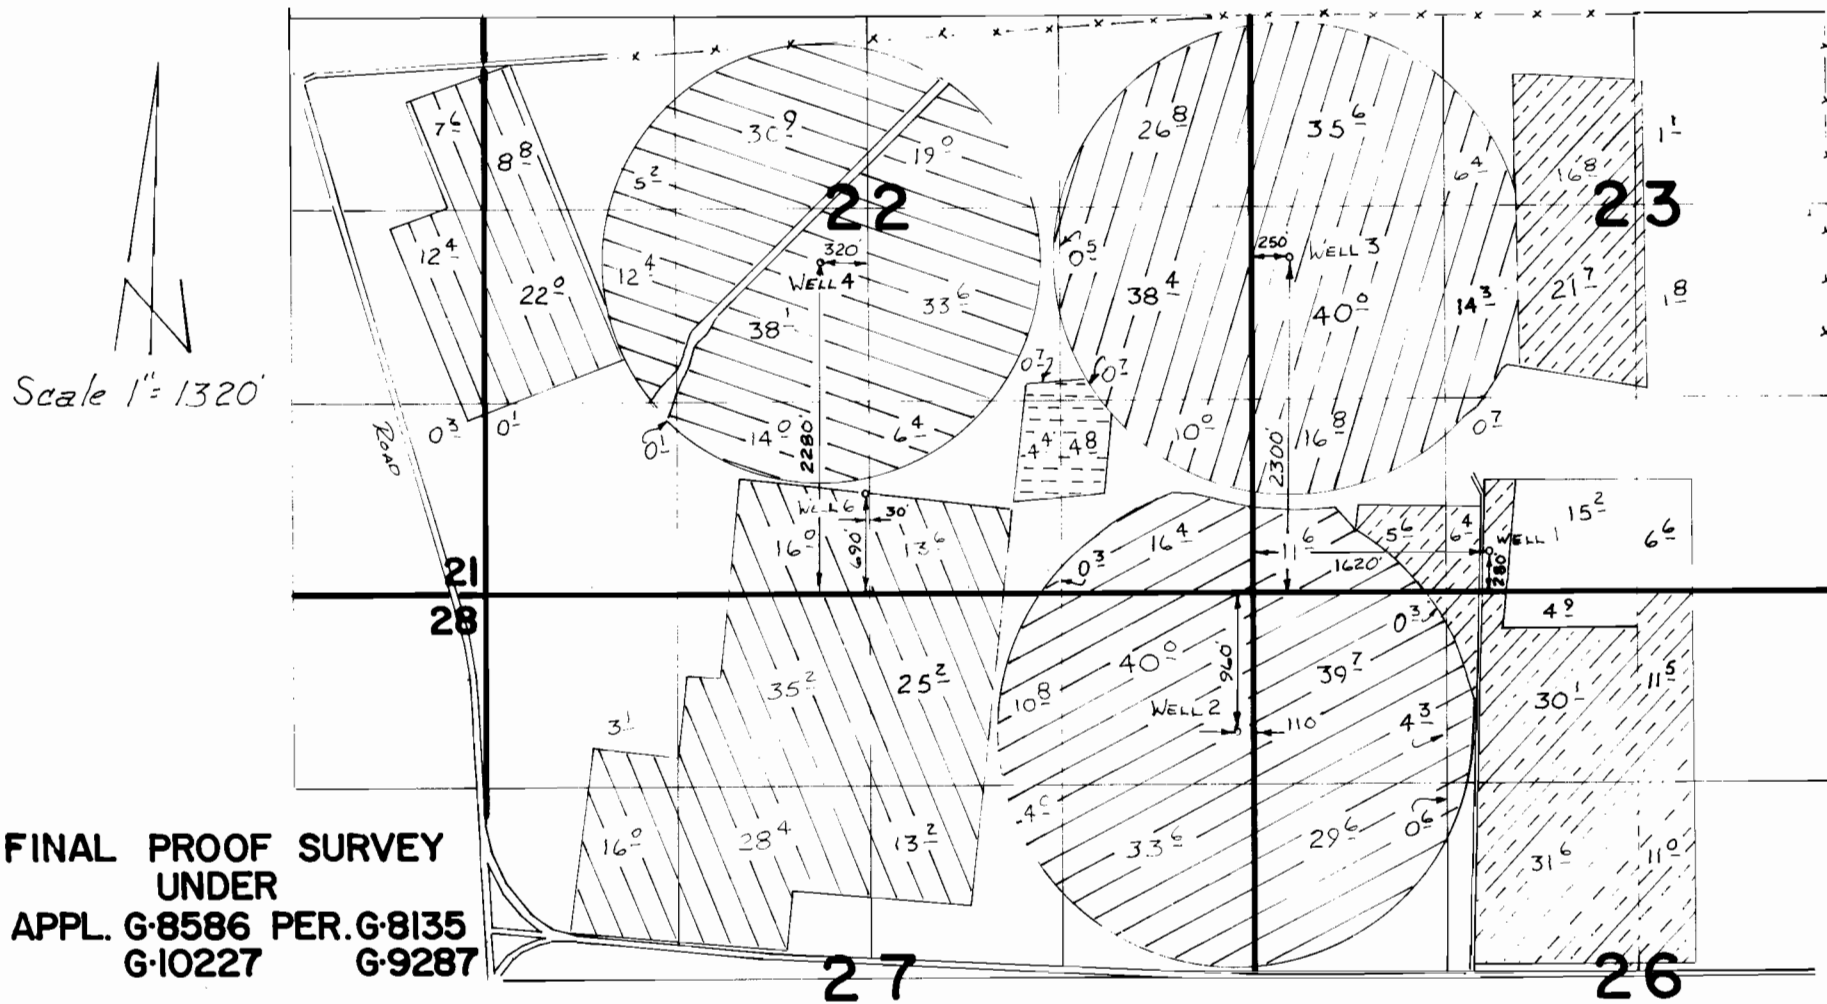

**FINAL PROOF SURVEY
UNDER
APPL. G-8586 PER. G-8135
G-10227 G-9287**

IN NAME OF

WALLY COLEMAN

	WELL #1 PRIM.	} PER. G-8135
	WELL #2 PRIM.	
	WELL #3 PRIM.	
	WELL #4 PRIM.	
	WELL #6 PRIM.	
	WELL #6 PRIM. PER. 9287	